.A. - - 2000

LAND CORNER RECORDATION CERTIFICATE

SECTION		F111	ng Requirement of A	ct 74, Mich. P.A. 1970	
For co	orners in				
Was	htenaw (County)	Located In:	Corner Code #		
1. Pul	olic Land Survey	T <u>2S</u> R <u>5E</u> T R T R		- Jezen -	5094723 Page: 1 of 2
in 3. Mi Pro	pperty Controlling S_ Section S_ scellaneous S_ pperty in Section S_ t No, Recorded	T R R R R R R R R R R R R R R R R R R R	Peggy M. Ha		02/07/2000 02:55P DRREM L-2 P-318 Sister of Deed Stamp & File Num F G H I J K L
	vate Claims			2 6 + 5 +	4 + 3 + 2 + 1
un me rul Ur de an La mo	Thomas L. Sutherland, in a fidder requirements of P.A. 74, 1 entioned in lines 1 and 2 aboves therefore as required in the sited States Department of the cree of a Court of Law and/ord 5 above were in conformant of Surveyors or by a Decree onumented, recovered, found OTE: Not more than 2 corner recorded on this certification of original monuments of C.L.O., 1819, Field Note 1) 30" W.O. S84°E 81 L 2) 18" W.O. N57°W 80.	Michigan P.A. of 1970 to were in conformance current manual of sure Interior, Bureau of Later that the corner points contained as expressed below: as expressed below: as all in the same town cate. The same town cate.	the corner points with regulations and revey instructions of the and Management or by a mentioned in lines 3, 4 michigan Board of tablished, re-established, and range, may be	5	9 - 10 - 11 - 12 16 - 15 - 14 - 13 21 - 22 - 23 - 24 1 - 1 - 1 28 - 27 - 26 - 25 1 - 1 - 1 33 - 34 - 35 - 36
	Continued on Back				
В.	Description of comer evidence				,
	Found 3/4" x 16" iron pip down 22" to large rock to remonumentation cap star around new pipe. This w	o large to remove. I mped 24620 over lar	Reset new 3/4" x 16" ironger took and replaced ro	on pipe with aluminum ocks previously removed	
C.	Description of monument for o	comer and accessories es	tablished to perpetuate locati	ng the position of the corner:	
	3/4" x 16" iron pipe with by samller rocks at North 3) 20" dead Cherry S65° 4) 14" Cherry S45°E 47 5) 28" Cherry S54°W 60 6) 34" Cherry S70°W 98 7) Remains of footing to 9) Re-rod surrounded by 10) Utility pole N2°E 22 11) Utility pole S2°E 47	edge of gravel 6" be 72.04 to Nail 30 to remon tag on S 0.35 to remon tag on S 333 to remon tag on SE corner of Barn Narocks South 33.14 .43 to remon tag on S4 to remon tag on S4 to remon tag on S5 to remon tag on S6 to re	elow surface. W Side NW Side N'ly Side 141°W 67.2 E. Side	4620 over large rock, sui	rounded
	12) Concrete monument13) South face of West e14) Bent iron pipe (1st in	South 43.00 and concrete curb (bu	iried) North 0.62	ook. No Date'') S45°E 8.0	08
	I conclude after careful street evidence of the position of	udy of the record docu	mentation and field obser	vation, that this corner is ac	
	Signed by: Surveyor's Michigan License	No. 24620	No. 24620	1-11-1	APPROVED /

No. 21620

APPROVED DATE 12(13 CO. REP.


A. Continued

Grid Book, No Date

"This is not the true corner. Mr. Atwell claims to have found the true corner several feet north".

(1st iron)

- 3) 5" Choke Cherry S69°E 64.7
- 4) 1 1/2" Choke Cherry S45°E 39.0
- 5) 12" B. Cherry S61°W 62.6
- 6) 16" B. Cherry S74°W 102.6
- 7) SE Cor. Barn N41°W 75.0

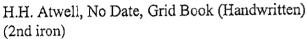

- 5) 10" Cherry S54°-15'W 60.3
- 6) 16" Cherry S70°W 98.6
- 7) SE Cor. Barn N41°W 67.5

Grid Book, No Date, (Handwritten) (2nd iron)

- 8) Tele pole N73°E 34.95
- 3) 16" W. Cherry S65°E 72.34
- 6) 27" W. Cherry S70°W 98.60

Washtenaw Engineering, N.N. Fahrner #17620, 1/18/72 L.C.R.C. Liber 1, Page 475; 1/25/72, Survey R-2644; 7/26/83, Survey R-4980

1" Iron Pipe (2nd iron)

- 5) 10" Cherry S54 1/2°W 60.3
- 6) 16" Cherry S70°W 97.9
- 7) SE Corner Barn N41°W 67.1

Control Survey Associates, R.T. Tietsema # 20712 6/7/74, Survey 2S5E22-74-15; 3/4/75, Survey 2S5E22-74-15

(2nd iron)

- 5) 30" Cherry S50°W 59.67 to SPK N. Side
- 6) 36" Cherry S75°W 97.98 to SPK N. Side
- 7) SE Corner Barn N41°W 67.5
- 9) R-O-W Iron South 33.07

Land Surveying Consultants, R.T. Tietsema # 20712, 5/98, Survey 02198-2S5E 14/15; 6/98, Survey 02198-2S5E 14/15

1" Iron Pipe (1st iron)

- 5) 18" Cherry S62°W 62.18
- 6) 24" Cherry S75°W 102.62
- 10) Utility Pole N08°W 27.95
- 11) Utility Pole S09°W 42.93



Peggy M. Haines - Washtenaw Co. CORREM

5094723 Page: 2 of 2 02/07/2000 02:55P

PEA.

..Ar -- 2000

SECTION