

REF. 2000

LAND CORNER RECORDATION CERTIFICATE
 Filing Requirement of Act 74, Mich. P.A. 1970

SECTION

For corners in

Washenaw (County) Located In: Corner Code #

1. Public Land Survey T 2S R 5E I-8

2. Property Controlling in Section S _____ T _____ R _____

3. Miscellaneous Property in Section S _____ T _____ R _____

4. Lot No. _____, Recorded Plat _____

5. Private Claims _____

Copy



5094724
 Page: 1 of 2
 02/07/2000 02:55P
 L-2 P-320
 Peggy M. Haines - Washtenaw Co. CORREM

Register of Deed Stamp & File Number

	A	B	C	D	E	F	G	H	I	J	K	L	M
1													
2	6		5		4		3		2		1		
3													
4	7		8		9		10		11		12		
5													
6	18		17		16		15		14		13		
7													
8	19		20		21		22		23		24		
9													
10	30		29		28		27		26		25		
11													
12	31		32		33		34		35		36		

I, Thomas L. Sutherland, in a field survey on 11/11/99 do hereby state that under requirements of P.A. 74, Michigan P.A. of 1970, the corner points mentioned in lines 1 and 2 above were in conformance with regulations and rules therefore as required in the current manual of survey instructions of the United States Department of the Interior, Bureau of Land Management or by a decree of a Court of Law and/or that the corner points mentioned in lines 3, 4 and 5 above were in conformance with the rules of the Michigan Board of Land Surveyors or by a Decree of a Court of Law; established, re-established, monumented, recovered, found as expressed below:

NOTE: Not more than 2 corners, all in the same town and range, may be recorded on this certificate.

- A. Description of original monument and accessories and/or subsequent resortation: 13
 G.L.O., 1819, Field Notes
 1) 6" B.O. S71°W 38 Links
 2) 8" W.O. S79°E 20 Links

- M. Thompson for C.W.A., 1934, Grid Book
 3) 28" W. Oak S73°E 13.2 to face of tree
 4) 20" B. Oak S50 1/4°W 106.3 to face of tree
 5) 14" Y. Oak N1 1/2°E 52.7 to face of tree

Continued on Back


B. Description of corner evidence found and/or method applied in restoring or re-establishing corner:
 Found 3/4" x 24" iron pipe 2" below gravel surface. Dug down 4' found nothing. Reset same 3/4" x 24" iron pipe with aluminum remonumentation cap stamped 24620 6" below gravel surface.

- C. Description of monument for corner and accessories established to perpetuate locating the position of the corner:
 3/4" x 24" iron pipe with aluminum remonumentation cap stamped 24620 6" below gravel surface
 6) Utility pole (new, but in same hole, per neighbor) N45°E 47.60 to remon tag on NW side
 7) Mult. 12" Cherry stump S25°E 98.37 to Spike on W'y Side
 11) 18" Ash S50°W 54.57 to remon tag on NW Side
 13) Twin 12" Hickory N89°E 51.47 to flasher
 14) East end 18" Culvert (CMP) S45°E 46.88 to notch in top center
 15) Steel fence post West 36.7
 16) 30" Walnut S20°E 121.04 to remon tag on W. Side
 17) 10" Oak S89°E 39.44 to remon tag on N. Side
 18) 12" Stump S15°E 77.40 to center
 19) Utility Pole N60°W 65.83 to flasher on NE Side
 20) Quad. 8"-10" Elm N20°W 33.62 to Spike
 21) Utility Pole East 75.72 to PK
 22) Conc. Monument West 42.91
 23) NW Cor. Base of Stone Pillar S85°E 43.08
 24) NW Cor. Base of Stone Pillar S50°E 50.18

APPROVED
 DATE 12/13/99
 CO. REP. KA

I conclude after careful study of the record documentation and field observation, that this corner is accepted as the best available evidence of the position of the original corner.

Signed by: Thomas L. Sutherland Date: 12/20/99
 Surveyor's Michigan License No. 24620

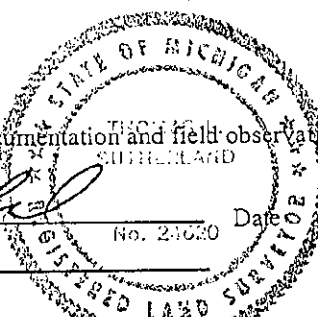

A. Continued

Grid Book, (Handwritten) No Date

- 6) Tele pole N45°E 47.59
- 7) 5"-10" W. Cherry S20°E 98.92
- 8) 12" Oak S25°W 122.68
- 9) Wooden Fence Post N65°W 39.74
- 10) Steel fence post S85°E 32.55

Control Survey Associates, R.T. Tietsema #20712, 6/7/74, Survey 2S5E22-74-15 ...

- 6) Power pole N50°E 47.59 to M.D.S.H. tag
- 7) 14" Tri. Cherry S23°E 98.44 to SPK W. Side
- 11) 6" Ash S45°W 54.21 to SPK E. Side
- 12) 30" Oak S20°E 167.7

Control Survey Associates, R.T. Tietsema #20712, 3/4/75, Survey 2S5E22-74-15

- 6) Power pole N50°E 47.59 M.S.S.H.
- 7) 14" Tri. Cherry S23°E 98.44 SPK
- 11) 6" Ash S45°W 54.21 SPK
- 12) 30" Oak S20°E 167.7

McNamee, Porter and Seeley, Arvin Butterfield #21561, 11/14/77, L.C.R.C. Liber 5, Page 18

- 3/4" Iron Pipe
- 6) Tele pole N45°E 47.60 to M.S.H.D. tag
- 13) Twin 8" Bitternut Hickory East 51.6
- 14) East End 18" Culvert S45°E 46.90 (CMP)
- 15) Fence Corner & Wooden Gate Post West 36.9

Washtenaw Engineering, N.N. Fahrner #17620, 11/3/78, L.C.R.C. Liber 5, Page 115; 11/10/78, Survey R-4259; 7/11/79, Survey R-4431; 10/5/79, Survey R-4500; 8/28/80, Survey R-4621

- 3/4" Iron Pipe
- 6) Telephone Pole N45°E 47.59
- 8) 12" Oak S25°E 122.68
- 16) 12" Walnut S25°E 121.2
- 13) 6" Twin Hickory N85°E 51.5

Land Surveying Consultants, R.T. Tietsema #20712, 10/82, Survey 1082-2S5E22; 10/83, Survey 7883-2S5E22; 8/89, Survey 08789-2S5E23

- 3/4" Iron Pipe
- 6) Telephone Pole N45°E 47.59
- 8) 12" Oak S25°W 122.68
- 16) 12" Walnut S25°E 121.2
- 13) 6" Twin Hickory N85°E 51.5

Washtenaw Engineering, N.N. Fahrner #17620, 8/3/83, Survey R-4987

- 3/4" Iron Pipe
- 6) Telephone Pole N45°E 47.59
- 7) Tw 5"-10" W. Cherry S20°E 98.92
- 8) 12" Oak S25°W 122.68
- 16) 12" Walnut S25°E 121.2
- 13) 6" Twin Hickory N85°E 51.5

Midwestern Consulting, D.M. Bongiovanni #245 7/18/90, L.C.R.C., Liber 7, Page 281; P.L. Hastings #37277, 1/5/99, Survey 98369 1" Iron Pipe

- 6) Tag S/Side MBT Pole N45°E 47.61
- 17) PK N/Side 6" Oak East 39.32
- 18) PK W/Side 8" Oak S25°E 77.31
- 19) PK NE/Side U.P. N60°W 65.70

Atwell-Hicks, R.G. Timmons, #23319, 1/8/90, Survey 506-155


- Iron Pipe
- 6) Tele pole N45°E 47.59
- 7) 12" Cherry S20°E 98.92
- 8) 16" Oak S25°E 122.68
- 9) Fence Post N65°W 39.74
- 10) Steel Fence Post S85°E 32.56

C. Wilson and Associates, C.C. Wilson #13604, 6/2/94, Survey 94091

- 1 1/4" Iron Pipe
- 6) Telephone pole N40°E 47.60 (nail)
- 16) 30" Walnut S20°E 121.17 (nail)
- 13) Twin 10"-12" Ash N85°E 51.44 (nail)
- 20) Quad 8"-12" Elm N20°W 34.85 (nail)
- 19) Utility Pole N65°W 65.84 (nail)

Land Surveying Consultants, R.T. Tietsema # 20 2/97, Survey 01897-2S5E22

- 1" Iron Pipe
- 6) Utility pole N45°E 47.61
- 18) 8" Oak S25°E 77.31
- 19) Utility Pole N60°W 65.70
- 21) Utility Pole East 75.74

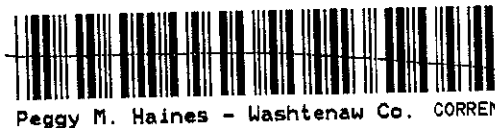

5094724 Page: 2 of 2 02/07/2000 02:55P

- Copy -

REF. SECTION