

RFI

2660

LAND CORNER RECORDATION CERTIFICATE
Filing Requirement of Act 74, Mich. P.A. 1970.

SECTION

For corners in

Washtenaw (County) Located In: Corner Code #
1. Public Land Survey T 2S R 5E I-13
2. Property Controlling in Section S T R
3. Miscellaneous Property in Section S T R
4. Lot No. Recorded Plat
5. Private Claims



5094729
Page: 1 of 2
02/07/2000 02:55P
L-2 P-329

Register of Deed Stamp & File Number

Grid table with columns A-M and rows 1-13. Contains numbers 6, 5, 4, 3, 2, 1, 7, 8, 9, 10, 11, 12, 18, 17, 16, 15, 14, 13, 19, 20, 21, 22, 23, 24, 30, 29, 28, 27, 26, 25, 31, 32, 33, 34, 35, 36.

I, Thomas L. Sutherland, in a field survey on 11-8-1999 do hereby state that under requirements of P.A. 74, Michigan P.A. of 1970, the corner points mentioned in lines 1 and 2 above were in conformance with regulations and rules therefore as required in the current manual of survey instructions of the United States Department of the Interior, Bureau of Land Management or by a decree of a Court of Law and/or that the corner points mentioned in lines 3, 4 and 5 above were in conformance with the rules of the Michigan Board of Land Surveyors or by a Decree of a Court of Law; established, re-established, monumented, recovered, found as expressed below:

NOTE: Not more than 2 corners, all in the same town and range, may be recorded on this certificate.

A. Description of original monument and accessories and/or subsequent resortation: 13

- G.L.O. 10/16/1815, Field Notes
1) 6" Elm N70°W 22Links
2) 6" Hickory S62°E 26 Links

Continued on Back

B. Description of corner evidence found and/or method applied in restoring or re-establishing corner:

Found 3/4" rod in monument box. Set aluminum remonumentation cap stamped 24620 over 3/4" rod in monument box.


C. Description of monument for corner and accessories established to perpetuate locating the position of the corner:

- 3/4" Iron rod with aluminum remonumentation cap stamped 24620 in monument box
4) 30" Hickory S33°E 185.10 to remon tag on NE side
6) Iron pipe (cap 6998) South 33.00
7) Iron rod (cap 20712) North 32.88
8) N. Post sections 3:2 Lodi East 120.60 (3/4" rod in monument box)
9) 20" Hickory S65°W 69.59 to remon tag on N.E. side
12) 20" Hickory N70°E 90.53 to remon tag on S.E. side
13) 6" Twin Chinese Elm North 26.61 to Nail on E. Side
14) S. End 72" CMP S60°E 61.51 to notch in top center
15) N. End 72" CMP N60°E 61.14 to notch in top center
21) Utility pole S70°E 92.25 to remon tag on N'y side
25) 10" Twin Elm N10°E 32.77 to remon tag on E'ly side.

I conclude after careful study of the record documentation and field observation, that this corner is accepted as the best available evidence of the position of the original corner. This corner is not common to I-1, T3S, R5E.

Signed by: [Signature] Date: 12/17/99

Surveyor's Michigan License No. 24620

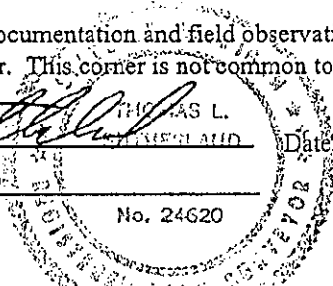

APPROVED
DATE 12/16/99
CO. REP. KA

A. Continued

## SECTION

H.H. Atwell #322, No Date, Grid Book  
Iron Pipe

- 3) 30" B. Oak N50 1/2°E 75.24
- 4) 18" Hickory S36°E 185.6
- 5) Center of S. End Culvert S85°E 53.0
- 6 & 7) 2 R. of W. Pipes
- 8) 120.64 East to N. Post of Secs. 3:2 Lodi

Handwritten in Grid Book, No Date

- 9) 12" Hickory S64°W 69.20 to Nail
- 10) Guard Post N56°W 34.85 to Nail
- 11) Guard Post S60°W 31.72 to Nail

R.T. Tietsema #20712, 1/20/75, L.C.R.C., Liber 3,  
page 597

Iron in monument box

- 8) North Corner of Sections 3:2 T3S, R5E, Lodi Township - Iron in monument box E'y 120.64
- 12) 12" S. Hickory N65°E 90.4
- 13) 6" Chinese Elm N1°E 27.9
- 9) 12" Hickory S70°W 69.3

Atwell-Hicks, R.J. Jagow #6998, 6/9/76, L.C.R.C.,  
L4, P134 - P.V. Schwimmer #24618, 8/20/77, Survey  
505-38

1/2" Rod in monument box

- 9) 18" Hickory S50°W 69.2
- 14) S. End CMP culvert S60°E 61.5
- 15) N. End CMP culvert N70°E 61.0
- 8) N.E. Corner Sec. 3 E'y 120.5

Washtenaw Engineering, N.N. Fahrner #17620,  
10/16/79 Survey R-4511

1" Iron Bar

- 16) 6" Tri. Elm N15°E 23.2
- 17) Power pole S50°E 60.5
- 18) 6" Pine N45°W 46.2
- 19) Power pole S65°W 99.5

Washtenaw Engineering, N.N. Fahrner #17620,  
5/27/81, L.C.R.C., Liber 6, page 151 - T.L. Sutherland  
#24620, 6/2/81 Survey R-4735

Iron pipe in monument box

- 8) 120.54 ft. East to N. Post Section 2:3 Lodi Township
- 9) 18" Hickory S64°W 69.20 to Nail
- 20) Tw. 8" Oak N'y 24.03 to Nail
- 21) Power pole S70°E 95.22 to Nail

Ayres, Lewis, Norris and May, C.C. Wilson #13604,  
9/20/85, Survey 82252-01

Iron pipe in monument box

- 8) 120.54 feet East to Lodi Twp. Corner
- 20) Twin 8" Oak N'y 24.03
- 21) Power pole S70°E 95.22
- 22) 20" Maple N53°W 83.8
- 23) 20" Stump N20°W 72.3
- 24) Center of concrete post N40°E 47.8

Washtenaw Engineering, N.N. Fahrner #17620  
3/28/95, Survey R-6894

Iron pipe in monument box

- 9) 18" Hickory S64°W 69.20 to Nail
- 20) Twin 8" Oak N'y 24.03 to Nail
- 21) Power pole S70°E 95.22 to Nail
- 8) N.E. Corner Section 3, Lodi Twp East 120.64

Washtenaw Engineering, N.N. Fahrner #17620  
5/16/97, Survey R-7376

Iron pipe in monument box

- 9) 24" Hickory S64°W 69.54 to P.K.
- 21) Power pole S70°E 95.11 to Nail
- 13) Twin 6" Elm North 26.65 to Nail
- 25) Twin 10" Elm N10°E 32.79 to Nail
- 8) N.W. Corner Section 2, Lodi Twp. West 120.64



- Copy -