

RFI

2000

LAND CORNER RECORDATION CERTIFICATE
Filing Requirement of Act 74, Mich. P.A. 1970

SECTION

For corners in

Washtenaw Located In: Corner Code #
(County)

- 1. Public Land Survey T 2S R 5E J-3
T ___ R ___
T ___ R ___
T ___ R ___
- 2. Property Controlling S ___ T ___ R ___
in Section S ___ T ___ R ___
- 3. Miscellaneous S ___ T ___ R ___
Property in Section S ___ T ___ R ___
- 4. Lot No. _____, Recorded Plat _____
- 5. Private Claims _____



5094731
Page: 1 of 2
02/07/2000 02:55P
L-2 P-333

Peggy M. Haines - Washtenaw Co. CORREM

Copy - Register of Deed Stamp & File Number

	A	B	C	D	E	F	G	H	I	J	K	L	M
1													
2	6		5		4		3		2		1		
3													
4	7		8		9		10		11		12		
5													
6	18		17		16		15		14		13		
7													
8	19		20		21		22		23		24		
9													
10	30		29		28		27		26		25		
11													
12	31		32		33		34		35		36		

I, Thomas L. Sutherland, in a field survey on 11-17-1999 do hereby state that under requirements of P.A. 74, Michigan P.A. of 1970, the corner points mentioned in lines 1 and 2 above were in conformance with regulations and rules therefore as required in the current manual of survey instructions of the United States Department of the Interior, Bureau of Land Management or by a decree of a Court of Law and/or that the corner points mentioned in lines 3, 4 and 5 above were in conformance with the rules of the Michigan Board of Land Surveyors or by a Decree of a Court of Law; established, re-established, monumented, recovered, found as expressed below:

NOTE: Not more than 2 corners, all in the same town and range, may be recorded on this certificate.

A. Description of original monument and accessories and/or subsequent resortation: 13

- G.L.O. 1819, Field Notes
- 1) 26" W.O. N18°W 63 Links
- 2) 28" W.O. S81°E 76 Links

- Pettibone, No Date, Grid Book
- 3) 24" W.O. S83 1/4°E 3.07
- 4) 28" W.O. S42 1/2°W 4.00
- Continued on Back

B. Description of corner evidence found and/or method applied in restoring or re-establishing corner:

Found 3/4" Iron pipe in very dense underbrush. Set aluminum remonumentation cap stamped 24620 over existing iron pipe.


C. Description of monument for corner and accessories established to perpetuate locating the position of the corner:

3/4" Iron Pipe with aluminum remonumentation cap stamped 24620 in very dense underbrush

- 6) 14" Dead pine S53°W 78
- 9) 12" Cedar N40°E 58.50 to remon tag on NW side
- 10) 16" Pine S70°W 78.47 to remon tag on S'y Side
- 11) 14" Pine East 29.32 to remon tag on S. Side
- 12) 6" Cherry North 26.81 to remon tag on W. Side
- 13) 15" Pine S58°E 22.94 to remon tag on SW Side

I conclude after careful study of the record documentation and field observation, that this corner is accepted as the best available evidence of the position of the original corner.

Signed by: Thomas L. Sutherland Date 12/20/99
Surveyor's Michigan License No. 24620

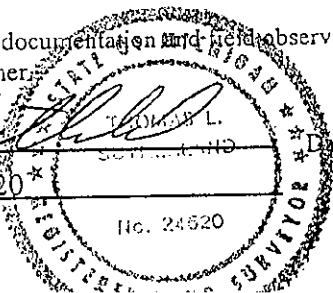

APPROVED
DATE 12/13/99
CO. REP. KX

Atwell-Hicks, R.J. Jagow #6998, 8/31/76, L.C.R.C.
Liber 4, Page 151; J.L. Snyder #13352, 6/7/79,
Survey 507-94

Found Nothing. Set I.P. on line midway between NE
Cor and NW Cor section

3/4" Iron Pipe in Stand of sumac

- 5) 3" Pine S58°E 33.2
- 6) 6" Pine S53 1/2°W 78.0
- 7) 3" - 6" Twin Cherry N40 1/2°E 113.8
- 8) 6" Elm N50°E 134.9
- 9) 1" Cedar bush N39 1/2°E -58.3



Peggy M. Haines - Washtenaw Co. CORREM L-2 P-334

5094731
Page: 2 of 2
02/07/2000 02:55P

- Copy

Washtenaw Engineering, N.N. Fahrner #17620
12/1/78, Survey R-4275; 8/19/86, Survey R-5486;
6/17/97, Survey R-7411

3/4" Iron Pipe

- 5) 3" pine S58°E 33.2
- 6) 6" Pine S53 1/2°W 78.0
- 8) 6" Elm N50°E 134.9
- 9) 1" Cedar bush N39°E 58.3

RECEIVED
FEB 7 2000

FEB 7 2000

SECTION