

SURVEY &
REMONUMENTATION

NOV 02 1999

LAND CORNER RECORDATION CERTIFICATE
Filing Requirement of Act 74, Mich. P.A. 1970

SECTION

For corners in

Washtenaw
(County)

Located In:

Corner Code #

1. Public Land Survey T 2S R 5E K-1
 T ___ R ___ Closing Corner
 T ___ R ___
 T ___ R ___
2. Property Controlling S ___ T ___ R ___
 in Section S ___ T ___ R ___
3. Miscellaneous S ___ T ___ R ___
 Property in Section S ___ T ___ R ___
4. Lot No. _____, Recorded Plat _____
5. Private Claims _____



5017330
Page: 1 of 2
02/26/1999 02:59P
Peggy M. Haines - Washtenaw Co. CORREM L-2 P-224
Register of Deed Stamp & File Number

Copy

I, Thomas L. Sutherland, in a field survey on, 11/13/98 do hereby state that under requirements of P.A. 74, Michigan P.A. of 1970, the corner points mentioned in lines 1 and 2 above were in conformance with regulations and rules therefore as required in the current manual of survey instructions of the United States Department of the Interior, Bureau of Land Management or by a decree of a Court of Law and/or that the corner points mentioned in lines 3, 4 and 5 above were in conformance with the rules of the Michigan Board of Land Surveyors or by a Decree of a Court of Law; established, re-established, monumented, recovered, found as expressed below:

	A	B	C	D	E	F	G	H	I	J	K	L	M
1													
2	6	5	4	3	2	1							
3													
4	7	8	9	10	11	12							
5													
6	18	17	16	15	14	13							
7													
8	19	20	21	22	23	24							
9													
10	30	29	28	27	26	25							
11													
12	31	32	33	34	35	36							
13													

A. Description of original monument and accessories and/or subsequent resortation:

- G.L.O., 1815, Field Notes
 1) 20" RO N23°W 27 Links
 2) 9" WO S44°E 37 Links

(Continued on other side)

B. Description of corner evidence found and/or method applied in restoring or re-establishing corner:

Found 1 1/2" Iron Pipe 0.5 South of East-West Fence Line and 1.8 West of Fence Line to the South. Dug down through roots to rusted off base of pipe and found nothing else. Reset 3/4" Iron Pipe with Aluminum Remonumentation Cap Stamped 24620.

C. Description of monument for corner and accessories established to perpetuate locating the position of the corner:

- 3/4" x 18" Iron Pipe with Remonumentation Cap stamped 24620
 4) 30" Hickory West 11.15 to W.C.R.C. Tag
 5) 20" Twin Basswood N05°E 13.28 to W.C.R.C. Tag on W. Side
 6) 30" Hickory S50°E 30.54 to W.C.R.C. Tag on S.W. Side
 7) 15" Hickory East 22.52 to W.C.R.C. Tag on N. Side
 8) R.R. Tie Corner Fence Post South 74.88 to W.C.R.C. Tag on W. Side
 9) K-13, T1S, R5E West 290.03 (along township line)


These are witnesses to a closing corner that is 9.66 South of the Township Line
 This corner is not common to K-13, T1S, R5E.

APPROVED
 DATE 12-14-98
 CO. REP. K

I conclude that after careful study of the record documentation and field observations, that this corner is accepted as the best available evidence of the position of the original corner.

Signed by: Thomas L. Sutherland Date 12-21-98

Surveyor's Michigan License No. 24620

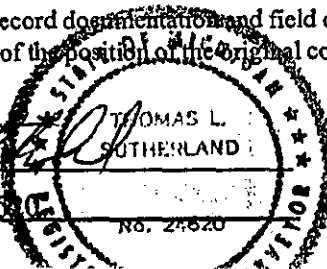

COPY

A. (Continued from Front)

S. Pettibone, Atwell-Hicks Composite Dwg. 207-70
3) Hickory S40°E 35 Links

Robert L. Smith #16052, 5-74, L.C.R.C. L3, P529
1 1/2" Iron Pipe

- 4) West 10.57 Nail in 24" Oak
- 5) North 13.20 Nail in 18" Oak
- 6) S45°E 31.42 Nail in 18" Oak



copy-

**SURVEY &
REMONUMENTATION**

NOV 02 1999

SECTION