

LAND CORNER RECORDATION CERTIFICATE
 Filing Requirement of Act 74, Mich. P.A. 1970

**SURVEY &
 REMONUMENTATION**

NOV 02 1999

SECTION

For corners in

Washtenaw
 (County)

Located In:

Corner Code #

1. Public Land Survey T 2S R 5E K-4
 T _____ R _____
 T _____ R _____
 T _____ R _____
2. Property Controlling S _____ T _____ R _____
 in Section S _____ T _____ R _____
3. Miscellaneous S _____ T _____ R _____
 Property in Section S _____ T _____ R _____
4. Lot No. _____, Recorded Plat _____
5. Private Claims _____

5017333
 Page: 1 of 2
 02/25/1999 02:59P
 Peggy M. Haines - Washtenaw Co. CORREM L-2 P-230
 Register of Deed Stamp & File Number

I, Thomas L. Sutherland, in a field survey on, 11/21/98 do hereby state that under requirements of P.A. 74, Michigan P.A. of 1970, the corner points mentioned in lines 1 and 2 above were in conformance with regulations and rules therefore as required in the current manual of survey instructions of the United States Department of the Interior, Bureau of Land Management or by a decree of a Court of Law and/or that the corner points mentioned in lines 3, 4 and 5 above were in conformance with the rules of the Michigan Board of Land Surveyors or by a Decree of a Court of Law; established, re-established, monumented, recovered, found as expressed below:

	A	B	C	D	E	F	G	H	I	J	K	L	M
1													
2	6		5		4		3		2		1		
3													
4	7		8		9		10		11	12			
5													
6	18		17		16		15		14		13		
7													
8	19		20		21		22		23		24		
9													
10	30		29		28		27		26		25		
11													
12	31		32		33		34		35		36		
13													

A. Description of original monument and accessories and/or subsequent resortation:

- G.L.O., Field Notes
 1) 16" WO N53°E 51 Links
 2) 14" WO N54°W 51 Links

(Continued on other side)

B. Description of corner evidence found and/or method applied in restoring or re-establishing corner:

Found 1" Iron Pipe surrounded by rocks. Removed and found nothing else. Replaced 1" Iron Pipe with 3/4" Iron Pipe inside. Set Aluminum Remonumentation Cap Stamped 24620 on 3/4" Iron Pipe.

C. Description of monument for corner and accessories established to perpetuate locating the position of the corner:


3/4" Iron Pipe with Aluminum Remonumentation Cap set inside 1" Iron Pipe surrounded by rocks.

- 4) 18" Walnut N12°W 220.62 to W.C.R.C. tag on W. side
- 6) 24" Walnut N22°E 251.40 to W.C.R.C. tag on W. side
- 9) Top Centerline S. End 18" Concrete End Section N56°E 92.03
- 11) NW Corner House Wing wall S33°E 101.09 to Brick
- 12) SW Corner House Wing wall S15°E 114.12 to Brick
- 13) Concrete Monument N01°W 68.50
- 14) 8" Pine S70°W 58.39 to W.C.R.C. tag on N. Side
- 15) 3" Twin Juniper East 14.68 to W.C.R.C. tag on N. Side
- 16) 6" Juniper N10°E 5.78 to W.C.R.C. tag on W. Side

APPROVED
 DATE 12-14-98
 CO. REP. Kix

I conclude that after careful study of the record documentation and field observations, that this corner is accepted as the best available evidence of the position of the original corner.

Signed by: Thomas L. Sutherland Date 12-21-98
 Surveyor's Michigan License No. 24620

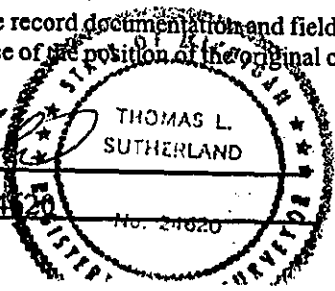

COPY

SURVEY &
REMONUMENTATION

NOV 02 1999

SECTION

A. (Continued from Front)

Atwell-Hicks Composite Dwg. 207-87

- 3) S.W. Corner Range House S70°E 206.25
- 4) 12" Walnut N20°W 221.1
- 5) Pointed Stone N80°E 135.7
- 6) 12" Walnut N25°E 25.20



5017333

Page: 2 of 2

02/25/1999 02:59P

L-2 P-231

Peggy M. Haines - Washtenaw Co. CORREM

copy

H.H. Atwell, Grid Book

- 5) Pointed Stone N80°E 133.70
- 4) 16" Walnut N20°W 221.1
- 6) 20" Walnut N25°W 252.0

Atwell-Hicks, R. Jagow #6998 8/6/76

L.C.R.C. L4, P152

1" Iron Pipe

- 6) 24" Walnut N20°E 252.5
- 7) 18" Walnut N11°E 250.4
- 8) 14" Walnut N4°E 226.6
- 4) 14" Walnut N14°W 221.2

Roskelly, Jekabson, I.J. Jekabson #19836

5/9/80 Dwg. 78-7-280-A

1" Iron Pipe

- 6) 24" Walnut N20°E 252.5
- 7) 18" Walnut N11°E 250.4
- 8) 14" Hickory N04°E 226.6
- 4) 14" Walnut N14°W 221.2

Ayres, Lewis, Norris, and May, C. Wilson #13604 4/2/84 Dwg.

1" Iron Pipe

- 6) 24" Walnut N20°E 252.5
- 7) 18" Walnut N11°E 250.4
- 8) 14" Walnut N04°E 226.6
- 4) 14" Walnut N14°W 221.2

Washtenaw Engineering, N. Fahrner #17620

2/19/85 Dwg. R-5199

Iron Pipe

- 5) Pointed Stone N80°E 133.7
- 4) 16" Walnut N20°W 221.1
- 6) 20" Walnut N25°E 252.0

C. Wilson and Assoc., C. Wilson #13604

10/27/88 Dwg. 88320

1" Iron Pipe

- 6) 24" Walnut N20°E 252.5
- 7) 18" Walnut N11°E 250.4
- 8) 14" Walnut N04°E 226.6
- 4) 14" Walnut N14°W 221.2

Atwell-Hicks, J. Snyder #13352

3/16/90 Dwg. 507-174

- 9) Black "T" top S. End 24" Culvert N45°E 92.1
- 10) Black Cross on large rock East 105.7
- 11) Corner of House S70°E 101.1
- 12) Corner of House S50°E 114.2