

**SURVEY &  
REMONUMENTATION**

MAR 09 1998

RECORDED  
WASHTENAW COUNTY, MI

JAN 22 8 32 AM '98

SECTION

**LAND CORNER RECORDATION CERTIFICATE**  
Filing Requirement of Act 74, Mich. P.A. 1970

PEGGY M. HAINES  
COUNTY CLERK REGISTER

For corners in

<u>Washtenaw</u> (County)	Located In:	Corner Code #
1. Public Land Survey	T <u>2S</u> R <u>5E</u>	<u>K-6</u>
	T ___ R ___	_____
	T ___ R ___	_____
	T ___ R ___	_____
2. Property Controlling in Section	S ___ T ___ R ___	_____
	S ___ T ___ R ___	_____
3. Miscellaneous Property in Section	S ___ T ___ R ___	_____
	S ___ T ___ R ___	_____
4. Lot No. _____, Recorded Plat _____		
5. Private Claims _____		

- COPY -

- COPY -

Liber **00002** Page **0059** RM

Register of Deed Stamp & File Number

I, Thomas L. Sutherland, in a field survey on 11/6, 1997 do hereby state that under requirements of P.A. 74, Michigan P.A. of 1970, the corner points mentioned in lines 1 and 2 above were in conformance with regulations and rules therefore as required in the current manual of survey instructions of the United States Department of the Interior, Bureau of Land Management or by a decree of a Court of Law and/or that the corner points mentioned in lines 3, 4 and 5 above were in conformance with the rules of the Michigan Board of Land Surveyors or by a Decree of a Court of Law; established, re-established, monumented, recovered, found as expressed below:

NOTE: Not more than 2 corners, all in the same town and range, may be recorded on this certificate.

	A	B	C	D	E	F	G	H	I	J	K	L	M
1													
2	6		5		4		3		2		1		
3													
4	7		8		9		10		11		12		
5													
6	18		17		16		15		14		13		
7													
8	19		20		21		22		23		24		
9													
10	30		29		28		27		26		25		
11													
12	31		32		33		34		35		36		
13													

A. Description of original monument and accessories and/or subsequent resortation:

- G.L.O. 1819, Field Notes
- 1) 16" B.O. S78°E 87 Links
  - 2) 21" Do S59°W 28 Links

Continued on other side

B. Description of corner evidence found and/or method applied in restoring or re-establishing corner:

Found 4" Iron Pipe 2.4 Feet below asphalt surface in middle of Southbound lane, Maple Road surrounded and partially covered by larger rocks. Raised with boat spike 6" below surface .14 West and .07 North. Raised with 3/4" Iron Pipe .22 West and .10 North. Reset 3/4" x 18" Iron Pipe with Aluminum Remonumentation cap Stamped 24620 in monument box.


C. Description of monument for corner and accessories established to perpetuate locating the position of the corner:

- 3/4" X 18" Iron Pipe with Aluminum Remonumentation cap stamped 24620 in Monument Box over 4" Iron Pipe and Large Rocks.
- 3) 18" Hickory N59°W 25.40 to Remon Tag and on S.W. side
  - 4) 34" Oak S76°W 51.70 to Remon Tag on North Side
  - 8) 24" Walnut N28°W 51.88 to Remon Tag on N.E. Side
  - 10) 24" Oak S55°E 55.00 to Remon Tag on S.W. Side
- Gas manhole (Westerly of 3) N50°E 51.26  
NE Corner of House S50°W 113.69

APPROVED  
DATE 12-2-97  
CO. REP. Ky

I conclude that after careful study of the record document and field observations, that this corner is accepted as the best available evidence of the position of the original corner.

Signed by: Thomas L. Sutherland Date 12-4-97  
Surveyor's Michigan License No. 24620

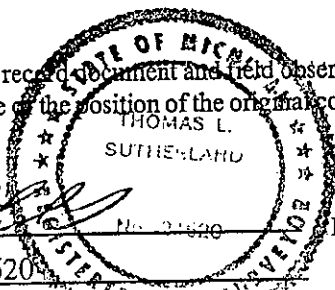

- COPY -

A. (Continued from Front)

H.H. Atwell #322 and others, No Date, Grid Book,  
Iron Pipe

- 3) 7" Hickory N59°W 25.4
- 4) 10" Maple S76°W 51.7
- 5) 12" W. Oak S58°E 33.4
- 6) 14" W. Oak N48°E 48.9
- 7) 13" Oak N22°W 41.32
- 8) 19" Oak N28°W 51.88
- 9) 11" Twin Cherry N32°W 22.59
- 10) 19" Oak S55°E 55.00

Atwell-Hicks, Dwg 206-63, 3-22-55

- 3) 7" Hickory N59°W 25.4
- 4) 10" Maple S76°W 51.7
- 5) 12" W. Oak S58°E 33.8
- 6) 14" W. Oak N40°E 48.9
- 11) 6" Cherry N46°W 25.6
- 7) 6" B. Oak N24°W 41.0

Washtenaw Engineering, N. Farhner #17620, 10-12-71  
Dwg R-2575; 10-13-71, L.C.R.C., Liber 1, Page 389; 5-11-72, Dwg. R-2750 and J.  
Oliver #19840, 11-1-72, Dwg. R-2906

- 3/4" Iron Pipe
- 3) 12" Hickory N59°W 25.4
  - 4) 28" Maple S76°W 51.7
  - 6) 28" W. Oak N48°E 48.9
  - 7) 14" Oak N22°W 41.32
  - 8) 20" Oak N28°W 51.88
  - 10) 24" Oak S55°E 55.0