

SURVEY & REMONUMENTATION

MAR 09 1998

RECORDED
WASHTENAW COUNTY, MI

JAN 22 8 32 AM '98

SECTION

LAND CORNER RECORDATION CERTIFICATE
Filing Requirement of Act 74, Mich. P.A. 1970

PEGGY A. HAINES
COUNTY CLERK/REGISTER

- COPY -

- COPY -

Liber 00002 Page 0063 RM

Register of Deed Stamp & File Number

For corners in

Washtenaw
(County)

Located In:

Corner Code #

- | | | |
|---------------------------------------|-------------------------|------------|
| 1. Public Land Survey | T <u>2S</u> R <u>5E</u> | <u>K-8</u> |
| | T ___ R ___ | _____ |
| | T ___ R ___ | _____ |
| | T ___ R ___ | _____ |
| 2. Property Controlling in Section | S ___ T ___ R ___ | _____ |
| | S ___ T ___ R ___ | _____ |
| 3. Miscellaneous Property in Section | S ___ T ___ R ___ | _____ |
| | S ___ T ___ R ___ | _____ |
| 4. Lot No. _____, Recorded Plat _____ | | |
| 5. Private Claims _____ | | |

I, Thomas L. Sutherland, in a field survey on 11/5, 1997 do hereby state that under requirements of P.A. 74, Michigan P.A. of 1970, the corner points mentioned in lines 1 and 2 above were in conformance with regulations and rules therefore as required in the current manual of survey instructions of the United States Department of the Interior, Bureau of Land Management or by a decree of a Court of Law and/or that the corner points mentioned in lines 3, 4 and 5 above were in conformance with the rules of the Michigan Board of Land Surveyors or by a Decree of a Court of Law; established, re-established, monumented, recovered, found as expressed below:

NOTE: Not more than 2 corners, all in the same town and range, may be recorded on this certificate.

	A	B	C	D	E	F	G	H	I	J	K	L	M
1													
2	6		5		4		3		2		1		
3													
4	7		8		9		10		11		12		
5													
6	18		17		16		15		14		13		
7													
8	19		20		21		22		23		24		
9													
10	30		29		28		27		26		25		
11													
12	31		32		33		34		35		36		
13													

A. Description of original monument and accessories and/or subsequent resortation:

- G.L.O. 1819, Field Notes
- 1) 18" W.O. N66°E 21 Links
 - 2) 20 B.O. N09°W 49 Links

Continued on other side

B. Description of corner evidence found and/or method applied in restoring or re-establishing corner:

Found 3/4" Iron Pipe in monument box. 6.7 Feet West of Painted Centerline.
Set Aluminum Remonumentation Cap Stamped 24620 over existing 3/4" Iron Pipe

C. Description of monument for corner and accessories established to perpetuate locating the position of the corner:

- 3/4" Iron Pipe with Aluminum Remonumentation Cap Stamped 24620 in mounment box.
- 3) 36" Oak N35°W 31.34 to Remon Tag on NE side
 - 7) 42" Oak S35°W 45.95 to MSHD Tag on SE side
 - 8) 1 1/2" Iron Pipe (Leaning Easterly) East 33.4
 - 14) 20" Oak S30°E 45.82 to Remon Tag on Westerly side
 - 15) 9" Pine S88°E 70.65 to Remon Tag on North side
 - 16) 26" Oak N20°W 75.00 to Nail on Easterly
 - 17) 40" Oak S10°W 96.80 to Nail on Easterly Side
 - 18) 12" Oak S29°W 75.90 to nail on Easterly Side
 - 20) 15" Cherry (Dead) N60°E 34.56 to Nail

I conclude after careful study of the record documentation and field observation, that this corner is accepted as the best available evidence of the position of the original corner.

APPROVED
DATE 12-2-97
CO. REP. FA

Signed by:


Thomas L. Sutherland

THOMAS L. SUTHERLAND

No. 24620 Date

12-4-97

Surveyor's Michigan License No. 24620

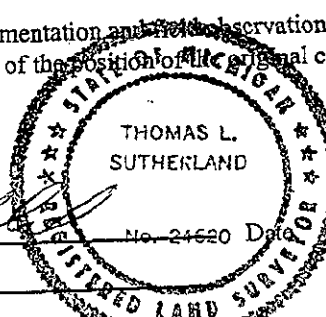

- Copy -

A. (Continued from Front)

W.C.R.C., W.J. Armstrong #2444, 9/15/33

Grid Book, Found a 1" Iron Pipe set in a platform of stones.

Placed 4 bricks around the top of the pipe

- 3) 14" W. Oak N35°W 31.4
- 4) 10" Cherry N20 1/2°E 72.4
- 5) 18" Apple S69°E 38.75
- 6) 12" Hickory S49°E 30.2
- 7) 18" B. Oak S30°W 45.5
- 8 & 9) 2 R of W Pipes

H.H. Atwell, #322, 1/21/46, Field Notes

- 5) 16" Apple Southeasterly 38.75
- 10) 16" Apple Southeasterly 58.7
- 6) 8" Hickory Southeasterly 30.4
- 7) 13" B.O. Southwesterly 45.6
- 3) 12" W. Oak Northwesterly 31.4

Michigan State Highway Dept. 1951, Grid Book

- 3) 22" W. Oak N35°W 31.4
- 4) 14" Cherry N20 1/2°E 72.4
- 6) 14" Hickory S49°E 30.2
- 7) 26" B. Oak S30°W 45.5
- 11) 6" Cherry S76°W 30.5
- 12) 5" Elm S58°E 91.2

Washtenaw Engineering, N. Fahrner #17620, 9/14/77, L.C.R.C.,
Liber 4, page 325 and Dwg. R-4007; 6/25/85, Dwg. R-5256; 3/8/
86, Dwg. R-5357; 12/17/86, Dwg. R-5463; 1/4/93 Dwg. R-6484;
11/17/94, Dwg. 6819

Iron Rod

- 3) 34" W. Oak N35°W 31.4
- 7) 36" Oak S32°W 45.97 to Flasher
- 14) 12" Oak S35°E 50.21 to Nail
- 15) 4" Pine East 70.65

Atwell-Hicks, R. Jagow #6993, 4/13/79, L.C.R.C., Liber 5,
Page 186 (Recorded as M-6, T2S, R5E)

1/2" Iron Pipe in New Pavement

- 3) 30" Burr Oak N40°W 31.4 (sp)
- 16) 26" Burr Oak N20°W 74.6
- 17) 30" Burr Oak S10°W 96.0
- 7) 30" Burr Oak S35°W 45.6

W.C.R.C., R. Campbell #13028, 7/13/79; found 3/8" Rerod
bent on Top driven into a 1 1/2" Iron Pipe. Raised with 3/4"
Iron Pipe in monument box

- 3) 32" W. Oak N35°W 31.79 to Nail
- 7) 36" R. Oak S30°W 45.93 to Flasher
- 14) 13" Oak S29°E 50.23 to Nail
- 15) 6" Pine East 70.7
- 18) 9" R. Oak S29°W 75.9
- 19) 26" Apple S24°E 84.8

Metro Engineers, 12/4/79, Job No. 79-203
Monument Box

- 3) 30" Oak N30°W 31.4 to Spike
- 14) 12" Oak S65°E 50.25 to Spike
- 20) 12" Cherry N40°E 34.80 to N&W
- 7) 36" Oak S35°W 45.95 to MSHD Tag

C. Wilson and Assoc., C. Wilson #13604, 9/25/86, Job No.
86213

1" Iron Pipe

- 3) 34" Oak N35°W 31.4
- 7) 36" Oak S32°W 45.97
- 14) 12" Oak S35°E 50.21
- 15) 4" Poplar Easterly 70.65

Midwestern Consulting, D. Bongioyanni #24586, 7/18/90,
L.C.R.C., Liber 7, Page 276

3/4" Iron Pipe

- 3) Nail NE/Side 40" Oak N30°W 31.34
- 7) Nail & Flasher SE/Side 40" Oak S40°W 45.95
- 14) PK SW/Side 15" Oak S30°E 45.82
- 20) PK NW/Side 12" Cherry N60°E 34.56