

- Copy -

LAND CORNER RECORDATION CERTIFICATE
Filing Requirement of Act 74, Mich. P.A. 1970

For corners in

Washtenaw Located In: Corner Code #
(County)

1. Public Land Survey T 2S R 5E K-12
T _____ R _____
T _____ R _____
T _____ R _____

2. Property Controlling S _____ T _____ R _____
in Section S _____ T _____ R _____

3. Miscellaneous S _____ T _____ R _____
Property in Sec. S _____ T _____ R _____

4. Lot No. _____, Recorded Plat _____

5. Private Claims _____

Register of Deeds Stamp & File Number

REC'D
WASHTENAW COUNTY, MI
MAR 29 1 51 PM '95

A	B	C	D	E	F	G	H	I	J	K	L

Thomas L. Sutherland in a field survey on October 9, 1995, do hereby certify that under requirements of P.A. 74, Michigan P.A. of 1970, the corner points mentioned in lines 1 and 2 above were in conformance with regulations and rules therefore as required in the current manual of survey instructions of the United States Department of the Interior, Bureau of Land Management or by a decree of a Court of Law and/or that the corner points mentioned in lines 3, 4 and 5 above were in conformance with the rules of the Michigan Board of Land Surveyors or by a Decree of a Court of Law; established, re-established, monumented, re-monumented, recovered, found as expressed below:

NOTE: Not more than 4 corners, all in the same town and range, may be recorded on this certificate.

A. Description of original monument and accessories and/or subsequent restoration:

Unknown G.L.O.	Field Notes	None	1) 11" Hickory S04°W 35 Links 2) 14" B. Oak N22°E 69 Links
May 10, 1932 W.C.R.C. W.J. Armstrong #2444	Grid Book	1" Iron Pipe Surrounded by Stones. 3 Bricks around Top of Pipe	3) 20" Hickory NE'ly 70.7 *4) 8" Hickory NW'ly 39.8 5) 8" W. Cherry SW'ly 30.3 6) 18" Hickory SE'ly 70.6 *7 &) 2 R.O.W. Pipes

(SECTION A. CONTINUED ON REVERSE SIDE)

B. Description of corner evidence found and/or method applied in restoring or reestablishing corner:

Found 3/4" Iron Pipe in Northbound Lane of Wagner Road at surface of asphalt from remaining witnesses.

- *15) Fence Post S50°W 40.25
- *16) Hydrant S50°E 43.93

*Old Witness Found

REC'D
WASHTENAW COUNTY, MI
MAR 29 1 51 PM '95

C. Description of monument for corner and accessories established to perpetuate locating the position of the corner:


I conclude that after careful study of the record documentation and field Observations, this corner is accepted as a careful and faithful perpetuation of the position of the original corner.

- 1" Iron Pipe W/W.C.R.P. Cap set in Monument Box
- *4) 18" Hickory Stump N40°W 40.00 to Tag in NE Side
- *7) 1 1/4" Iron Pipe EAST 33.00
- *8) 1 1/4" Iron Pipe WEST 32.80
- *9) 20" Hickory Stump N35°W 49.27 to Tag in NE Side
- *10) 12" Hickory Stump N25°W 72.53 to Tag in NE Side
- *11) 36" Oak N20°W 95.98 to Tag in NE Side
- *13) 8" Ash N85°E 26.70 to Tag in N. Side
- *15) Fence Post S50°W 40.23 to Tag in S.W. Side
- *16) Hydrant S50°W 40.23 to
- 17) Power Pole N55°W 46.09 to Tag in S.W. Side

Signed by Thomas L. Sutherland Date December 11, 1995

Surveyor's Michigan License No. #24620

*Old Witness Found

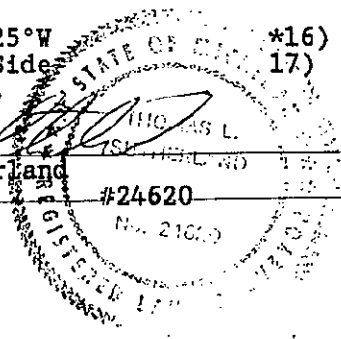

- copy -

(CONTINUED FROM A. ON FRONT)

	Survey	Iron Pipe	None
Oct. 30 1969 Washtenaw Engineering	2088		
March 7, 1977 Atwell-Hicks R.J. Jagow #6998	Act 74, L.G.R.C. Liber 4, Page 194	1/2" Iron Pipe 0.2 deep	*4) 12" Hickory N50°W 40.0 *9) 12" Hickory N40°W 49.8 *10) 6" Hickory N25°W 72.7 *11) 24" Oak N20°W 96.4
May 27, 1981 Washtenaw Engineering N. Fahrner #17620	Act 74, L.G.R.C. Liber 6, Page 150	3/4" Iron Pipe in Northbound Lane	*4) 8" Hickory NW'ly 39.95 to Nail 12) MBT Pole N85°W 30.26 to Nail *13) 4" Cherry N85°E 27.54 to Nail 14) Speed Limit Sign N25°E 74.5
August 8, 1984 W.C.R.C. BCS, ROM, ACC	Field Notes	Found 1/2" x 18" No New Witnesses Iron Pipe. Reset 3/4" x 18" Iron Pipe and Cap at Road Surface	
August 23, 1990 Land Surveying Consultants R.T. Tietsema #20712	Survey 11590-2S5E36	3/4" Iron Pipe	*13) Locust N80°E 27.61 12) Power Pole N88°E 30.44 *15) Fence Post S50°W 40.25 *16) Hydrant S50°E 43.93
Jan. 28, 1992 Washtenaw Engineering N.N. Fahrner #17620	Survey R-6348	3/4" Iron Pipe w/W.C.R.C. Cap	12) P.Pole N85°W 30.19 to Nail *13) 4" Ash N85°E 27.55 to Nail *4) 18" Hickory N35°W 40.00 to Nail *9) 20" Hickory N20°W 49.25 to Nail

*Old Witness Found

APPROVED

DATE 11/6/95

CO. REP. *[Signature]*