

**SURVEY &
REMONUMENTATION**

Liber **00001** Page **0549-RN**

MAY 09 1996

**LAND CORNER RECORDATION CERTIFICATE
Filing Requirement of Act 74, Mich. P.A. 1970**

For corners in **COMMISSION**

-copy-

<u>Washtenaw</u> <small>(County)</small>	Located In:	Corner Code #
1. Public Land Survey	T <u>2S</u> R <u>5E</u>	<u>K-13</u>
	T _____ R _____	_____
	T _____ R _____	_____
	T _____ R _____	_____
2. Property Controlling in Section	S _____ T _____ R _____	_____
	S _____ T _____ R _____	_____
3. Miscellaneous Property in Sec.	S _____ T _____ R _____	_____
	S _____ T _____ R _____	_____

REGISTERED
 WASHTEENAW COUNTY, MI
 MAR 29 1 51 PM '96
 COUNTY CLERK REGISTER
-copy-

Register of Deeds Stamp & File Number

4. Lot No. _____, Recorded Plat _____
 5. Private Claims _____

	A	B	C	D	E	F	G	H	I	J	K	L	M
2	6		5		4		3		2		1		
3													
4	7		8		9		10		11		12		
5													
6	18		17		16		15		14		13		
7													
8	19		20		21		22		23		24		
9													
10	30		29		28		27		26		25		
11													
12	31		32		33		34		35		36		
13													

Thomas L. Sutherland in a field survey on October 9, 1995, do hereby certify that under requirements of P.A. 74, Michigan P.A. of 1970, the corner points mentioned in lines 1 and 2 above were in conformance with regulations and rules therefore as required in the current manual of survey instructions of the United States Department of the Interior, Bureau of Land Management or by a decree of a Court of Law and/or that the corner points mentioned in lines 3, 4 and 5 above were in conformance with the rules of the Michigan Board of Land Surveyors or by a Decree of a Court of Law; established, re-established, monumented, re-monumented, recovered, found as expressed below:

NOTE: Not more than 4 corners, all in the same town and range, may be recorded on this certificate.

A. Description of original monument and accessories and/or subsequent restoration:

1815 G.L.O.	Field Notes	Unknown	1)	8" Ironwood S54°W 14 Links
			2)	30" R. Oak S57°E 23 Links
September, 1932 W.C.R.G. W.J. Armstrong #2444	Grid Book	Screw Bolt with Bricks around Top	3)	10" Maple N70°W 85.7
			4)	14" Maple N49°W 45.7
			5)	18" Maple N21 1/4°W 72.4
			*6)	12.3 East of N. Post Section 1:2 Lodi

(SECTION A. CONTINUED ON REVERSE SIDE)

B. Description of corner evidence found and/or method applied in restoring or reestablishing corner:

Found 3/4" Iron Pipe W/Cap at road surface in center of Scio Church Road and 9.0+ East of center of Wagner Road from remaining witnesses.

*Old Witness Found

C. Description of monument for corner and accessories established to perpetuate locating the position of the corner:

I conclude that after careful study of the record documentation and field observations, this corner is accepted as the best available evidence of the position of the original corner:
 1" Iron Pipe W/W.G.R.P. Cap set in Monument Box


*6)	Iron Pipe K-1 T3S, R5E WEST 12.39	*14)	Stop Sign S15°E 58.85
*7)	N.W. Corner Concrete 1' Sq. Post (leaning SE) N45°E 47.88	*15)	Stop Sign S50°W 67.75
*8)	SE Corner House N45°W 95.87 to Ftg.	16)	18" Maple N40°W 84.36 to Tag in N.E. Side
*9)	24" Maple N55°W 83.41 to Tag in S.W. Side	17)	Power Pole S30°W 107.82 to Tag in S.E. Side
*11)	Utility Pole S65°W 98.11 to Tag in N. Side	18)	Power Pole N45°W 58.85 to Tag in S.W. Side
*12)	Power Pole N45°E 45.33 to Tag in S.E. Side	19)	12" Pear S60°E 87.68 to Tag in N.E. Side

December 11, 1995

Signed by Thomas L. Sutherland
 Surveyor's Michigan License No. #24620

Date _____

*Old Witness Found

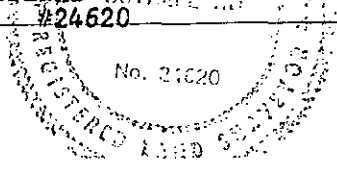

- Copy -

(CONTINUED FROM A. ON FRONT)

March 7, 1977 Atwell-Hicks R.J. Jagow #6998	Act 74, L.C.R.C. Liber 4, Page 194	1" Iron Pipe (Original Description) Found 1/2" Re-Rod in New Monument Box	4) Maple N49°W 45.7 5) Maple N21°W 72.4 *7) NW Corner Concrete 1' Post N45°E 47.8 *8) SE Corner House N45°W 95.8 *6) NE Corner Section 2, Lodi WEST 12.38 5) 20" Maple N25°W 72.4 *9) 18" Maple N55°W 83.9 *7) Center Concrete Post N40°E 47.8 *6) NE Corner Section 2, Lodi WEST 12.40
Jan. 9, 1985 W.C.R.C. R. Campbell #13028	Act 74, L.C.R.C. Liber 7, Page 42	3/4" Iron Pipe and Cap at Road Surface	5) 20" Stump N20°W 72.3 *9) 20" Maple N53°W 83.8 *7) Center Concrete Post N50°E 47.9 *6) NE Corner Section 2, Lodi WEST 12.39 *10) Centerline Wagner Road WEST 9.0 *11) Telephone Pole S86°W 97.6
May 10, 1990 Washtenaw Engineering H.L. O'Donnell #28419	Survey R-6104	Unknown	*12) Power Pole N49°E 45.30 to Na: 13) Power Pole S20°W 104.30 to Na: *11) Utility Pole S60°W 98.19 to Na: *8) SE Corner House N45°W 95.75
August 23, 1990 Land Surveying Consultants R.T. Tietsema #20712	Survey 11590-2S5E36	3/4" Iron Rod in Monument Box	*12) Power Pole N45°E 45.30 *14) Stop Sign S15°E 58.85 *15) Stop Sign S50°W 67.75 *9) 24" Maple N50°W 83.41
March 23, 1994 Washtenaw Engineering N.N. Fahrner #17620	Survey R-6682	Unknown	*12) Power Pole N49°E 45.30 to Na: 13) Power Pole S20°W 104.30 to Na: *11) Utility Pole S60°W 98.19 to Na: *8) SE Corner House N45°W 95.75

APPROVED

DATE

11/6/95

CO. REP.

KX