

NOV 02 1999

SECTION

LAND CORNER RECORDATION CERTIFICATE
Filing Requirement of Act 74, Mich. P.A. 1970

Or corners in _____

Washtenaw Located In: _____ Corner Code # _____
(County)


Public Land Survey T 2S R 5E _____ L-3
T _____ R _____ _____
T _____ R _____ _____
T _____ R _____ _____

Property Controlling S _____ T _____ R _____
in Section _____ T _____ R _____

Miscellaneous S _____ T _____ R _____
Property in Section S _____ T _____ R _____

Lot No. _____, Recorded Plat _____

Private Claims _____



5017335
Page: 1 of 2
02/25/1999 02:59P
L-2 P-234
Peggy M. Haines - Washtenaw Co. CORREM
Register of Deed Stamp & File Number

	A	B	C	D	E	F	G	H	I	J	K	L	M
1													
2	6	5	4	3	2	1							
3													
4	7	8	9	10	11	12							
5													
6	18	17	16	15	14	13							
7													
8	19	20	21	22	23	24							
9													
10	30	29	28	27	26	25							
11													
12	31	32	33	34	35	36							
13													

I, Thomas L. Sutherland, in a field survey on, 11/10/98 do hereby state that under requirements of P.A. 74, Michigan P.A. of 1970, the corner points mentioned in lines 1 and 2 above were in conformance with regulations and rules therefore as required in the current manual of survey instructions of the United States Department of the Interior, Bureau of Land Management or by a decree of a Court of Law and/or that the corner points mentioned in lines 3, 4 and 5 above were in conformance with the rules of the Michigan Board of Land Surveyors or by a Decree of a Court of Law; established, re-established, monumented, recovered, found as expressed below:

A. Description of original monument and accessories and/or subsequent resortation:
G.L.O. 1815 Field Notes
1) 12" Lynn N85°W 22 Links
2) 16" Lynn N81°E 31 Links
(Continued on other side)


B. Description of corner evidence found and/or method applied in restoring or re-establishing corner:
Found 1" Iron Pipe (rusted off at ground level) in remains of East-West Fence Line and Range of tree Line to the North. Pipe was surrounded by rocks below ground surface. Removed Pipe and found nothing else. Reset 3/4" x 18" Iron Pipe with Aluminum Remonumentation Cap stamped 24620.

C. Description of monument for corner and accessories established to perpetuate locating the position of the corner:
3/4" Iron Pipe with Remonumentation Cap stamped 24620
5) 36" Oak N15°E 5.34 to W.C.R.C. Tag on S.E. Side
6) 14" Rotted Elm Stump wrapped in fence wire East 13.6
7) 6" Hickory N60°W 11.71 to W.C.R.C. Tag on S.W. Side
9) 14" Hickory N20°W 14.12 to Ambit Flasher on E. Side
10) 12" Hickory North 16.03 to W.C.R.C. Tag on E. Side
11) 18" Oak N02°W 14.41 to W.C.R.C. Tag on E. Side
12) 14" Walnut S80°E 48.49 to W.C.R.C. Tag on S. Side
13) 14" Elm S50°W 36.83 to W.C.R.C. Tag on S.E. Side

APPROVED
DATE 12-14-98
K
A

I conclude that after careful study of the record documents and field observations, that this corner is accepted as the best available evidence of the position of the original corner.

Signed by: Thomas L. Sutherland
Surveyor's Michigan License No. 24620

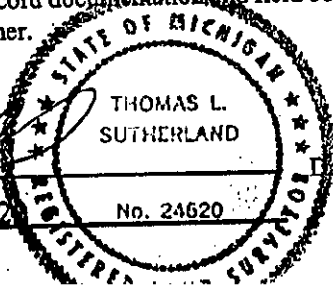

12-21-98 COPY

SURVEY &
REMONUMENTATION

NOV 02 1999

SECTION

A. (Continued from Front)

H.H. Atwell #322, Grid Book
Iron Pipe

- 3) W. Oak 7" N15°E 10.8
- 4) W. Oak 9" N60°E 41.3

W.C.R.C., W.J. Armstrong, #2444, 1936 Grid Book

- 5) Forked S.W. Oak 16" N20°E 5.9
- 6) Elm 10" East 13.6
- 7) Hickory 3" N70°W 11.7
- 8) Hickory 5" N50°W 15.5
- 9) Hickory 5" N30°W 14.5
- 10) Hickory 6" N2°W 15.7



5017335

Page: 2 of 2

02/25/1999 02:59P

Peggy M. Haines - Washtenaw Co. CORREM L-2 P-235

-copy-

Washtenaw Engineering, N. Fahrner #17620
11/10/78, L.C.R.C. L5, P150; 11/16/78 Dge. R-4262;
11/6/80 Dwg. R-4670
1" Iron Pipe

- 5) 20" Forked Oak N20°E 5.9
- 8) Hickory Stump N50°W 14.7
- 9) 12" Hickory N30°W 14.5
- 10) 16" Hickory N02°W 15.7

Atwell-Hicks, R. Timmons #23319, 12/22/86

Dwg. 107-160; R. Macomber #27453, 3/27/87

Dwg. 507-150; J. Snyder #13352, 7/10/87

Dwg. 507-155, 7/10/87 Dwg. 507-156 7/10/87 Dwg. 507-157, 8/12/87

Dwg. 507-158, 8/12/87 Dwg. 507-159, 6/15/88

Dwg. 507-177

1" Iron Pipe

- 5) 24" Forked Oak P.K. E. Side N20°E 5.40
- 9) 12" Hickory P.K. W. Side N30°W 14.65
- 11) 16" Oak P.K. E. Sde N02°W 14.65
- 8) Hickory Stump P.K. S. Side N50°W 14.81