

LAND CORNER RECORDATION CERTIFICATE
 Filing Requirement of Act 74, Mich. P.A. 1970

SURVEY &
 REMONUMENTATION

NOV 02 1999

corners in
Washtenaw
 (County)

Located In:

Corner Code #

SECTION

Public Land Survey

T 2S R 5E M-3

T ___ R ___

T ___ R ___

T ___ R ___

T ___ R ___

T ___ R ___

T ___ R ___

T ___ R ___

Property Controlling
 in Section

S ___

S ___

S ___

S ___

Miscellaneous

Property in Section

Lot No. _____, Recorded Plat _____

Private Claims _____



5017337

Page: 1 of 2

02/25/1999 02:59P

L-2 P-238

Peggy M. Haines - Washtenaw Co. CORREM

Register of Deed Stamp & File Number

Copy

	A	B	C	D	E	F	G	H	I	J	K	L	M
1													
2	6		5		4		3		2		1		
3													
4	7		8		9		10		11		12		
5													
6	18		17		16		15		14		13		
7													
8	19		20		21		22		23		24		
9													
10	30		29		28		27		26		25		
11													
12	31		32		33		34		35		36		
13													

Thomas L. Sutherland, in a field survey on November 4, 1998 do hereby state that under requirements of P.A. 74, Michigan P.A. of 1970, the corner points mentioned in lines 1 and 2 above were in conformance with regulations and rules therefore as required in the current manual of survey instructions of the United States Department of the Interior, Bureau of Land Management or by a decree of a Court of Law and/or that the corner points mentioned in lines 3, 4 and 5 above were in conformance with the rules of the Michigan Board of Land Surveyors or by a Decree of a Court of Law; established, re-established, re-monumented, recovered, found as expressed below:

A. Description of original monument and accessories and/or subsequent resortation:

G.L.O. 1815 Field Notes

- 1) 14" W.O. S52°E 40 Links
- 2) 9" W.O. S6°W 23 Links

(Continued on Other Side)

B. Description of corner evidence found and/or method applied in restoring or re-establishing corner:

Found 1/2" Iron Pipe 6" below gravel surface inside of 1" Iron Pipe 12" below gravel surface. The 1" Iron Pipe was surrounded by large rocks. Set a 3/4" Iron Pipe with an Aluminum Remonumentation Cap stamped 24620 over the 1/2" Iron Pipe.

C. Description of monument for corner and accessories established to perpetuate locating the position of the corner:


- 3/4" Iron Pipe with Remon Cap stamped 24620 over a 1/2" Iron Pipe that is inside a 1" Iron Pipe surrounded by large rocks.
- 6) 26" Hickory N39°E 62.57 to W.C.R.C. Tag on NW Side
- 9) 17" Hickory S89°W 43.35 to W.C.R.C. Tag on N Side
- 15) Twin 10" Oak N45°W 29.04 to Ambit Tag on NE Side
- 16) 12" Hickory N45°E 43.18 to W.C.R.C. Tag on NW Side
- 17) 10" Ash East 29.10 to W.C.R.C. Tag on S. Side
- 14) 8" Dead Ash S60°E 32.95 to Nail on SW Side
- 15) A-3, T2S, R6E North 257.61

This Corner is not common to A-3, T2S, R6E.

APPROVED
 DATE 12-14-98
 CO. REP. [Signature]

I conclude that after careful study of the record documentation and field observations, that this corner is accepted as the best available evidence of the position of the original corner.

Signed by: Thomas L. Sutherland
 Surveyor's Michigan License No. 24620

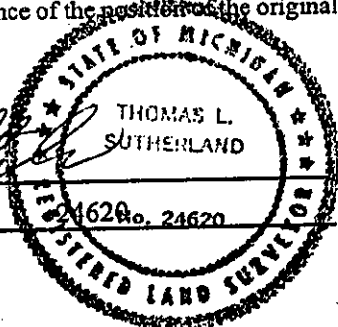

Date

12-21-98

COPY

A. Continued from Front

H.H. Atwell #332, Grid Book
Iron Pipe

- 3) Hickory 7" N60°W 25.25
- 4) Hickory 9" N70°E 28.0
- 5) Elm 10" N65°E 35.2
- 6) Hickory 18" N39°E 62.6
- 7) B. Oak 28" S30°W 56.5
- 8) Hickory 14" S83°W 20.15
- 9) Hickory 10" S89°W 43.4
- 10) Hickory 14" N23°W 44.4



5017337

Page: 2 of 2

02/25/1999 02:59P

Peggy M. Haines - Washtenaw Co. CORREM L-2 P-239

- Copy

**SURVEY &
REMONUMENTATION**

NOV 02 1999

SECTION

Washtenaw Engineering, N. Fahrmer #17620
11/10/78 L.C.R.C. L5, P150; 11/16/78 Dwg. R-4262; 11/6/80 Dwg. R-4670;
5/29/81 L.C.R.C. L6, P152

1/2" Iron Pipe

- 5) Elm Stump N65°E 35.2
- 6) 20" Hickory N39°E 62.6
- 7) 28" B. Oak S30°W 56.5
- 9) 14" Hickory S89°W 43.4
- 11) 6" Cedar S30°W 34.8

Atwell-Hicks 2/9/89 Dwg. 507-172

1/2" Iron Pipe

- 6) 18" Hickory N39°E 62.6
- 8) 14" Hickory (Stump) S85°W 20.15
- 9) 10" Hickory S89°W 43.40
- 12) 12" Hickory N15°W 76.20

R.T. Tietsema #20712 10/11/89

L.C.R.C. (L&P unknown)

1/2" Iron Pipe

- 6) 20" Hickory N39°E 62.57 to Nail
- 13) 6" Poplar East 28.25 to Nail
- 14) 6" Cherry S60°E 32.60 to Nail
- 12) 16" Hickory S89°E 43.40 to Nail