

LAND CORNER RECORDATION CERTIFICATE

Filing Requirement of Act 74, Mich. P.A. 1970

SURVEY & REMONUMENTATION

NOV 02 1999

SECTION

corners in  
Washtenaw  
(County)

Located In:

Corner Code #

Public Land Survey

T 2S R 5E M-4

T R

T R

T R

T R

T R

T R

T R

Property Controlling  
in Section

S

S

S

S

Miscellaneous

Property in Section

Lot No. , Recorded Plat

Private Claims



5017238

Page: 1 of 2

02/25/1999 02:59P

L-2 P-240

Peggy M. Haines - Washtenaw Co. CORREM

Register of Deed Stamp & File Number

*Copy*

	A	B	C	D	E	F	G	H	I	J	K	L	M
1													
2	6		5		4		3		2		1		
3													
4	7		8		9		10		11		12		
5													
6	18		17		16		15		14		13		
7													
8	19		20		21		22		23		24		
9													
10	30		29		28		27		26		25		
11													
12	31		32		33		34		35		36		
13													

Thomas L. Sutherland, in a field survey on November 4, 1998 do hereby state that under requirements of P.A. 74, Michigan P.A. of 1970, the corner points mentioned in lines 1 and 2 above were in conformance with regulations and rules therefore as required in the current manual of survey instructions of the United States Department of the Interior, Bureau of Land Management or by a decree of a Court of Law and/or that the corner points mentioned in lines 3, 4 and 5 above were in conformance with the rules of the Michigan Board of Land and Surveyors or by a Decree of a Court of Law; established, re-established, monumented, recovered, found as expressed below:

A. Description of original monument and accessories and/or subsequent resortation:

- G.L.O. 1815 Field Notes
- 1) 18" B.O. North 150 Links

(Continued on Other Side)

B. Description of corner evidence found and/or method applied in restoring or re-establishing corner:

Found 1" Iron Gas Pipe. Removed and found nothing else. Replaced with 3/4" Iron Pipe with Aluminum Remonumentation Cap stamped 24620.

C. Description of monument for corner and accessories established to perpetuate locating the position of the corner:

- 3/4" Iron Pipe with Remon Cap stamped 24620.
- 5) 18" Hickory S59°E 38.14 to Remon Tag on SW Side
- 6) 26" Oak N17°W 110.26 to Remon Tag on E Side
- 7) 39" Oak West 72.21 to Remon Tag on S Side
- 8) 14" Oak N85°E 20.44 to Remon Tag on N Side
- 11) 12"-8" Twin Hickory N45°E 26.93 to Nail on NW Side
- 13) 18" Twin Oak S25°W 78.39 to Remon Tag on SE Side

This Corner is not common to A-4, T2S, R6E.


APPROVED

DATE 12-14-98

CO. REP. *[Signature]*

I conclude that after careful study of the record documentation and field observations, that this corner is accepted as the best available evidence of the position of the original corner.

Signed by: *[Signature]*  
Surveyor's Michigan License No. 24620 No. 24620

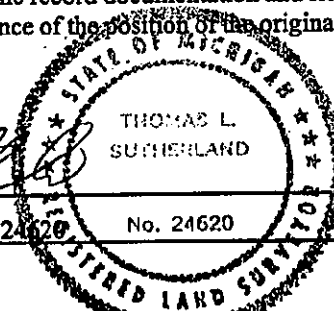

Date

12-21-98

COPY

A. (Continued from Front)

H.H. Atwell #332, Grid Book

Iron Pipe

- 2) B. Walnut 10" N79°W 19.1
- 3) B. Walnut 10" N84°W 38.5
- 4) Group B.O. Sprouts from Pettibone's Tree S60°W 36.3
- 5) Hickory 10" S59°E 38.1
- 6) B. Oak 24" N17°W 110.1



*- Copy -*

**SURVEY &  
REMONUMENTATION**

**NOV 02 1999**

**SECTION**

Washtenaw Engineering, J. Oliver #19840 7/23/74

L.C.R.C. L4, P102; C. Wilson #13604 7/23/74 Dwg: R-3342

- 2) 14" B. Walnut N79°W 19.1
- 3) 14" B. Walnut N84°W 38.5
- 6) 30" Oak N17°W 110.1

Washtenaw Engineering, T. Sutherland 12/9/76 Field Notes

1" Iron Pipe (bent)

- 2) B. Walnut 20" N79°W 19.1
- 3) B. Walnut 18" N84°W 38.5
- 5) Hickory 14" S59°E 38.1
- 6) B. Oak 28" N17°W 110.1

Atwell-Hicks, J. Snyder #13352 11/26/79 Dwg. 507-98

- 7) 36" Oak West 72.4
- 8) 12" Oak East 20.7
- 9) 8"12" Twin Shag Hickory N32°E 45.9
- 5) 18" Shag Hickory S60°E 37.9

Atwell-Hicks, R. Macomber #27453

8/31/84 Dwg. 507-127

1" Iron Pipe

- 10) 1" Iron Pipe N23°W 76.01
- 3) 24" Stump West 37.96 (Nail)
- 11) Twin 8" Hickory N45°E 27.98 (Nail)

Atwell-Hicks 2/9/89 Dwg. 507-172

- 5) P.K. SW Side 16" Hickory S59°E 38.10
- 6) P.K. E. Side 28" B. Oak N17°W 110.10
- 7) P.K. S. Side 30" Walnut West 72.26
- 12) F. Spk. NW Side 8" Oak S45°W 26.75