

**SURVEY &
REMONUMENTATION**

MAR 09 1998

SECTION

LAND CORNER RECORDATION CERTIFICATE
Filing Requirement of Act 74, Mich. P.A. 1970

RECORDED
WASHTENAW COUNTY, MI

JAN 22 8 32 AM '98

PEGGY M. HAINES
COUNTY CLERK/REGISTER

- COPY -

- COPY -

For corners in

<u>Washtenaw</u> (County)	Located In:	Corner Code #
1. Public Land Survey	T <u>2S</u> R <u>5E</u>	<u>M-6</u>
	T ___ R ___	_____
	T ___ R ___	_____
	T ___ R ___	_____
2. Property Controlling in Section	S ___ T ___ R ___	_____
	S ___ T ___ R ___	_____
3. Miscellaneous Property in Section	S ___ T ___ R ___	_____
	S ___ T ___ R ___	_____
4. Lot No. _____, Recorded Plat _____		
5. Private Claims _____		

Liber **00002** Page **0069** **RM**
Register of Deed Stamp & File Number

	A	B	C	D	E	F	G	H	I	J	K	L	M
1													
2	6		5		4		3		2		1		
3													
4	7		8		9		10		11		12		
5													
6	18		17		16		15		14		13		
7													
8	19		20		21		22		23		24		
9													
10	30		29		28		27		26		25		
11													
12	31		32		33		34		35		36		
13													

I, Thomas L. Sutherland, in a field survey on 11/10, 1997 do hereby state that under requirements of P.A. 74, Michigan P.A. of 1970, the corner points mentioned in lines 1 and 2 above were in conformance with regulations and rules therefore as required in the current manual of survey instructions of the United States Department of the Interior, Bureau of Land Management or by a decree of a Court of Law and/or that the corner points mentioned in lines 3, 4 and 5 above were in conformance with the rules of the Michigan Board of Land Surveyors or by a Decree of a Court of Law; established, re-established, monumented, recovered, found as expressed below:

NOTE: Not more than 2 corners, all in the same town and range, may be recorded on this certificate.

A. Description of original monument and accessories and/or subsequent resortation:

G.L.O. 1819, Field Notes

- 1) 14" W.O. N53°E 31 Links
- 2) 14" W.O. N05°W 36 Links

H.H. Atwell, #322, No Date, Grid Book
Iron Pipe

- 3) 14" B. Oak S51°W 49.2
- 4) 28" B. Oak N61°W 68.9
- 5) 24" B. Oak S18°W 82.7
- 6) Steel Fence Post S55°W 30.4
- 7) 10" B. Oak S18°E 56.3

W.C.R.C., W.J. Armstrong #2444, 12/5/39

- 8) 15" Elm S071/2°E 120.75
- 9) 20" Elm S08°W 164.7
- 10) 30" Maple S12°W 142.9
- 11) 12" Apple S42°W 73.0

Atwell-Hicks, Field Notes, 1/30/56
1/2" Iron Pipe

- 13) 24" Black Oak N61°W 69.9

B. Description of corner evidence found and/or method applied in restoring or re-establishing corner:

Found 1/2" Iron Rod (bent and broken) over 1 1/2" x 24" Bent Iron pipe (top .3 North) in center of Maple Road pavement. Found fire brick around Iron Pipe 12" below pavement. Reset 3/4" x 18" Iron Pipe with Aluminum Remonumentation Cap Stamped 24620 in monument box

C. Description of monument for corner and accessories established to perpetuate locating the position of the corner:

3/4" x 18" Iron Pipe with Remonumentation Cap Stamped 24620 in monument box.
12" Cherry N55°W 65.37 to Remon Tag on Southwest Side
18" Walnut S35°W 90.55 to Remon Tag on Southeast Side
NW Corner metal Ameritech Box N80°E 31.05 at ground
Power pole S40°E 50.93 to Remon Tag on Southwest Side
7" Cherry N40°E 59.17 to Remon Tag on Northwest Side


APPROVED

DATE 12-2-97

CO. REP. KJ

I conclude after careful study of the record documentation and field observation, that this corner is accepted as the best available evidence of the position of the original corner.

Signed by: Thomas L. Sutherland
Surveyor's Michigan License No. 24620

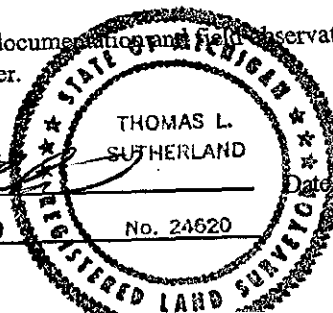

12-4-97