

SURVEY &
REMONUMENTATION

MAR 09 1998

SECTION

LAND CORNER RECORDATION CERTIFICATE
Filing Requirement of Act 74, Mich. P.A. 1970

RECORDED
WASHTENAW COUNTY, MI

JAN 27 8 32 AM '98

PEGGY W. JAINES
COUNTY CLERK/REGISTER

- COPY -

- COPY -

Liber 00002 Page 0070 RM

Register of Deed Stamp & File Number

For corners in

<u>Washtenaw</u> (County)	Located In:	Corner Code #
1. Public Land Survey	T <u>2S</u> R <u>5E</u>	<u>M-7</u>
	T ___ R ___	_____
	T ___ R ___	_____
	T ___ R ___	_____
2. Property Controlling in Section	S ___ T ___ R ___	_____
	S ___ T ___ R ___	_____
3. Miscellaneous Property in Section	S ___ T ___ R ___	_____
	S ___ T ___ R ___	_____
4. Lot No. _____, Recorded Plat _____		
5. Private Claims _____		

I, Thomas L. Sutherland, in a field survey on 11/10, 1997 do hereby state that under requirements of P.A. 74, Michigan P.A. of 1970, the corner points mentioned in lines 1 and 2 above were in conformance with regulations and rules therefore as required in the current manual of survey instructions of the United States Department of the Interior, Bureau of Land Management or by a decree of a Court of Law and/or that the corner points mentioned in lines 3, 4 and 5 above were in conformance with the rules of the Michigan Board of Land Surveyors or by a Decree of a Court of Law; established, re-established, monumented, recovered, found as expressed below:

NOTE: Not more than 2 corners, all in the same town and range, may be recorded on this certificate.

	A	B	C	D	E	F	G	H	I	J	K	L	M
1													
2		6		5		4		3		2		1	
3													
4		7		8		9		10		11		12	
5													
6		18		17		16		15		14		13	
7													
8		19		20		21		22		23		24	
9													
10		30		29		28		27		26		25	
11													
12		31		32		33		34		35		36	
13													

A. Description of original monument and accessories and/or subsequent resortation:

- G.L.O. 1819, Field Notes
1) 9" Ironwood S04°E 10 Links
2) 24" R.O. S45°W 16 Links

Continued on other side

B. Description of corner evidence found and/or method applied in restoring or re-establishing corner:

Found bolt (1" square head) over 3/4" Iron Pipe in monument box at intersection of centerlines Maple Road with entrance and exit ramps to eastbound M-14. Set Aluminum Remonumentation Cap Stamped 24620 over bolt in monument box

C. Description of monument for corner and accessories established to perpetuate locating the position of the corner:

- Aluminum Remonumentation Cap Stamped 24620 over 1" square head bolt in 3/4" Iron Pipe in monument box.
11) 24" Oak N49°W 104.72 to Remon Tag on Southwest Side
14) Iron Pipe in Monument Box A-7, T2S, R6E North 224.97
15) Utility Pole N45°E 143.95 to Remon Tag on Southeast Side
16) Utility Pole S52°E 96.07 to Remon Tag on Southwest Side
18) 18" Hickory S45°W 105.62 to Remon Tag on Southeast Side
19) 10" Poplar N48°W 83.00 to Remon Tag on Northeast Side
20) 6" Ash N38°E 87.97 to Remon Tag on Southeast Side
21) 8" Walnut S40°W 77.23 to Remon Tag on Southeast Side

APPROVED

DATE 12-2-97

CO. REF. KA


I conclude after careful study of the record documentation and field observation, that this corner is accepted as the best available evidence of the position of the original corner.

Signed by:

Thomas L. Sutherland
THOMAS L. SUTHERLAND
No. 24620

12-4-97

Surveyor's Michigan License No. 24620

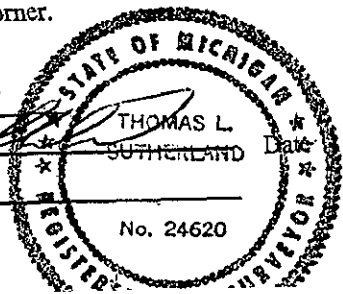

- COPY -

A. (Continued from Front)

H.H. Atwell, #322, No Date, Grid Book

Iron Pipe

- 3) 14" W. Oak Southwest 27.93 (37.95 on A-H composite Drawing)
- 4) 10" B. Oak NW 35.2
- 5) 10" Elm SW 45.4
- 6) 10" B. Oak NE 53.3
- 7) 10" B. Oak SE 78.5

M.S.H.D., Grid Book, No date, Atwell

Witnesses Do not Check. Rewitnessed

- 3) 20" Tw. Oak S75°W 37.69
- 8) 16" Hickory S55°W 37.07
- 9) 12" Hickory N45°E 45.11
- 10) 14" Hickory N40°W 56.32

Atwell-Hicks, P. Schwimmer #24618, 8/24/77, L.C.R.C., Liber 4, Page 313

3/4" Iron Pipe in Monument box on centerline

Bituminous Maple Road on centerline

Bituminous X-Way Ramps East and West

- 11) 20" White Oak N45°W 104.6
- 12) 8" Hickory S50°W 142.5
- 13) 12" Hickory N40°E 105.3