

SURVEY & REMONUMENTATION

MAR 09 1998

LAND CORNER RECORDATION CERTIFICATE

Filing Requirement of Act 74, Mich. P.A. 1970

RECORDED
WASHTENAW COUNTY, MI

JAN 22 8 32 AM '90

SECTION

For corners in

<u>Washtenaw</u> (County)	Located In:	Corner Code #
1. Public Land Survey	T <u>2S</u> R <u>5E</u>	<u>M-8</u>
	T ___ R ___	_____
	T ___ R ___	_____
	T ___ R ___	_____
2. Property Controlling in Section	S ___ T ___	R ___ _____
	S ___ T ___	R ___ _____
3. Miscellaneous Property in Section	S ___ T ___	R ___ _____
	S ___ T ___	R ___ _____
4. Lot No. _____, Recorded Plat _____		
5. Private Claims _____		

PEGGY A. HAINES
COUNTY CLERK/REGISTER

- COPY -

- COPY -

Liber **00002** Page **0072** RM

Register of Deed Stamp & File Number

I, Thomas L. Sutherland, in a field survey on 11/11, 1997 do hereby state that under requirements of P.A. 74, Michigan P.A. of 1970, the corner points mentioned in lines 1 and 2 above were in conformance with regulations and rules therefore as required in the current manual of survey instructions of the United States Department of the Interior, Bureau of Land Management or by a decree of a Court of Law and/or that the corner points mentioned in lines 3, 4 and 5 above were in conformance with the rules of the Michigan Board of Land Surveyors or by a Decree of a Court of Law; established, re-established, monumented, recovered, found as expressed below:

NOTE: Not more than 2 corners, all in the same town and range, may be recorded on this certificate.

A. Description of original monument and accessories and/or subsequent resortation:

G.L.O. 1819, Field Notes

- 1.) 10" W.O. S04°W 69 Links
- 2.) 10" Hickory N42°W 56 Links

Atwell-Hicks, R. Harris #25846, 10/30/87, Dwg. 506-135 and L.C.R.C.

Liber 7, Page 144
Capped Iron Pipe

H.H. Atwell, #322, No Date, Grid Book and Field Notes

- 3) 10' Hickory NE 7.6
- 4) 36' B. Oak N78 1/2°W 48.9
- 5) 14" Elm S41 1/2°W 18.6
- 6) 20" Elm S64 1/2°E 45.0
- 7) 10" Hickory N37°E 69.4
- 8) 18" Elm N14°W 45.0

- 9) Light Pole N19°W 74.45
- 10) Power Pole S17°W 88.97
- 11) 36" Oak S26°E 90.3
- 12) SW Corner of House 1108 N88°E 71.55

B. Description of corner evidence found and/or method applied in restoring or re-establishing corner:

Found 3/4" x 18" Iron Pipe at paved Maple Road surface. Removed and did not detect anything else. Reset 3/4" x 18" Iron Pipe with Aluminum Remonumentation Cap Stamped 24620 in Monument Box.

C. Description of monument for corner and accessories established to perpetuate locating the position of the corner:

3/4" x 18" Iron Pipe with Aluminum Remonumentation Cap Stamped 24620 in Monument Box.

- 9) Light Pole N19°W 74.60 to Remon Tag in Southwest Side
- 10) Power Pole S17°W 88.63 to Remon Tag in Northwest Side
- 11) 36" Oak S26°E 90.65 to Remon Tag in Southwest Side
- 12) SW Corner of house 1108 N88°E 71.49
- 14" Maple N40°E 45.37 to Remon Tag on Northwest Side
- West Edge Gutter Pan East 21.23
- East Edge Gutter Pan West 22.10


APPROVED

DATE 12-2-97

CO. REP. KX

I conclude after careful study of the record documentation and field observation, that this corner is accepted as the best available evidence of the position of the original corner.

Signed by: Thomas L. Sutherland
Surveyor's Michigan License No. 24620

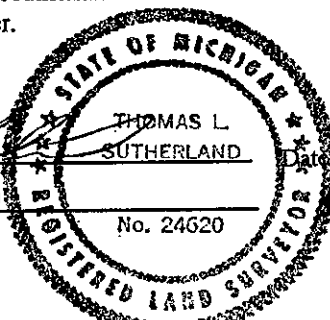

12-4-97
