

APPROVED
 DATE 11-20-96
 CO. REF. KA

LAND CORNER RECORDATION CERTIFICATE
Filing Requirement of Act 74, Mich, P.A. 1970

RECORDED
 WASHTEENAW COUNTY, MI
 FEB 18 9 05 AM '97
 PEGGY A. HAINES
 COUNTY CLERK/REGISTRAR

For corner in Washtenaw (County) Located in: Corner Code #

1. Public Land Survey	T <u>2S</u>	R <u>6E</u>	<u>G-9</u>
	T _____	R _____	_____
	T _____	R _____	_____
	T _____	R _____	_____
2. Property Controlling in Section	S _____	T _____	R _____
	S _____	T _____	R _____
3. Miscellaneous Property in Sec	S _____	T _____	R _____
	S _____	T _____	R _____

4. Lot No. _____, Recorded Plat _____
 5. Private Claims _____

Liber 000001 Page 0585 pm

Register of Deeds Stamp & File Number

1	A	B	C	D	E	F	G	H	I	J	K	L	M
2	6	5	4	3	2	1							
3													
4	7	8	9	10	11	12							
5													
6	18	17	16	15	14	13							
7													
8	19	20	21	22	23	24							
9													
10	30	29	28	27	26	25							
11													
12	31	32	33	34	35	36							
13													

I, Charles C. Wilson, in a field survey on November 1, 19 96, do hereby certify that under requirements of P.A. 74, Michigan P.A. of 1970, the corner points mentioned in lines 1 and 2 above were in conformance with regulations and rules therefore as required in the current manual of survey instruction of the United States Department of the interior, Bureau of Land Management or by a decree of a Court of Law and/or that the corner points mentioned in lines 3, 4 and 5 above were in conformance with the rules of the Michigan Board of Land Surveyors or by a Decree of a Court of Law; established, re-established, monumented, re-monumented, recovered, found as expressed below.

NOTE: Not more than 4 corners, all in the same town and range, may be recorded on this certificate.

A. Description of original monument and accessories and/or subsequent restoration.

United States Government Survey, 1815 Instructions, Surveyed 1819
 Bearing Trees W. Oak 11" S48deg.E 9.24
 W. Oak 13" N12deg.E 37.62
 Meas. (E) 2690.5
 (S) 2640

Continued on Back:

SURVEY &
 REMONUMENTATION
 MAY 05 1997
 COMMISSION


B. Description of corner evidence found and/or method applied in restoring or reestablishing corner:

Found 1" Iron Pipe in monument Box from information and accessories mentioned in Paragraph A

C. Description of monument for corner and accessories established to perpetuate locating the position of the corner:

Set Remonumentation Cap Stamped #13604 on existing 1" Iron Pipe in Monument Box
 22" Stump N30deg.E 43.0 *
 Light Pole N50deg.W 58.0 to center*
 Twin 9"-12" Box Elder N5deg.W 55.12 (Nail & RT E/S of 12")
 16" Pine N30deg.E 50.80 (Nail & RT E/S)
 18" Pine N50deg.E 84.77 (Nail & RT W/S)
 Back of Concrete Curb NORTH 7.00
 * Indicates accessory previously mentioned in Paragraph A
 RT Indicates Remonumentation Tag
 I believe this point should be accepted as the best available evidence of the position of the original corner.
 This point was ratified by the Washtenaw County Peer Committee on November 20, 1996.

COPY

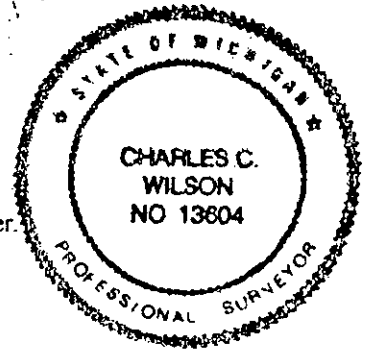

Signed by - Charles C. Wilson
 Surveyors Michigan's License No. 13604

Date November 21, 1996

