

APPROVED
DATE 11-20-96
CO. REP. KX

LAND CORNER RECORDATION CERTIFICATE
Filing Requirement of Act 74, Mich, P.A. 1970

RECORDED
 WASHTEENAW COUNTY, MI
 FEB 18 9 05 AM '97
 PEGGY M. HAINES
 COUNTY CLERK/REGISTER

For corner in Washtenaw (County) Located in: _____ Corner Code # _____

1. Public Land Survey	T <u>2S</u>	R <u>6E</u>	<u>G-10</u>
	T _____	R _____	_____
	T _____	R _____	_____
	T _____	R _____	_____
2. Property Controlling in Section	S _____	T _____	R _____
	S _____	T _____	R _____
3. Miscellaneous Property in Sec	S _____	T _____	R _____
	S _____	T _____	R _____

4. Lot No. _____, Recorded Plat _____

5. Private Claims _____

Liber 00001 Page 0583 pm

Register of Deeds Stamp & File Number

	A	B	C	D	E	F	G	H	I	J	K	L	M
1													
2	6	5	4	3	2	1							
3													
4	7	8	9	10	11	12							
5													
6	18	17	16	15	14	13							
7													
8	19	20	21	22	23	24							
9													
10	30	29	28	27	26	25							
11													
12	31	32	33	34	35	36							
13													

I, Charles C. Wilson, in a field survey on November 1, 19 96, do hereby certify that under requirements of P.A. 74, Michigan P.A. of 1970, the corner points mentioned in lines 1 and 2 above were in conformance with regulations and rules therefore as required in the current manual of survey instruction of the United States Department of the Interior, Bureau of Land Management or by a decree of a Court of Law and/or that the corner points mentioned in lines 3, 4 and 5 above were in conformance with the rules of the Michigan Board of Land Surveyors or by a Decree of a Court of Law; established, re-established, monumented, re-monumented, recovered, found as expressed below.

NOTE: Not more than 4 corners, all in the same town and range, may be recorded on this certificate.

Description of original monument and accessories and/or subsequent restoration:

United States Government Survey, 1815 Instructions, Surveyed 1819
 Bearing Trees W. Oak 13" S32deg.E 22.44
 W. Oak 13" S86deg.E 17.16
 Meas. (N) 2640'
 (S) 2640'

Continued on Back:


SURVEY &
 REMONUMENTATION
 MAY 05 1997
 COMMISSION

Description of corner evidence found and/or method applied in restoring or reestablishing corner:

Found 1" Iron Pipe in a 4" Iron Pipe filled with concrete, 6" below ground surface from information and accessories mentioned in Paragraph A.

Description of monument for corner and accessories established to perpetuate locating the position of the corner:

Set Remonumentation Cap Stamped #13604 on 1" Iron Pipe in Concrete
 42" Oak N20deg.W 160.1' ***
 24" Hickory N60deg.W 99.1' *
 Twin 18" Cherry W'y 65.71' (Nail & RT)
 14" Hickory N60deg.W 75.47' (Nail & RT)
 12" Oak N20deg.W 70.91' (Nail & RT)
 Concrete Monument, at Northwest Corner of HIGHLAND TERRACE, Liber 16, Page 1, E'y 454.91'
 * Indicates accessory previously mentioned in Paragraph A
 RT Indicates Remonumentation Tag
 I believe this point should be accepted as the best available evidence of the position of the original corner.
 This point was ratified by the Washtenaw County Peer Committee on November 20, 1996.

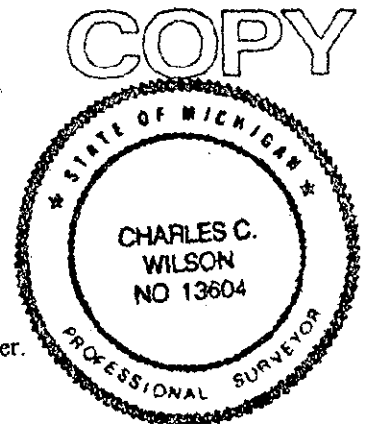

Signed by Charles C. Wilson
 Surveyors Michigan's License No. 13604

Date November 21, 1996

Paragraph A Continued:

J.B. Davis, November 1902

Book 9, Page 47

Found remains of previously described Cedar Post. Reset with 1" x 55" Iron Pipe with Flat Blue Stone on Top.

W. Oak 20" N10deg.W 160.55'

Hickory 11" N20deg.W 49.10'

Hickory 11" N50deg.W 98.60'

Elm 6" S60deg.E 36.0'

Plat of HIGHLAND TERRACE, Liber 16, Page 1, July 13, 1961

Atwell-Hicks, Inc., December 1972

Robert J. Jagow, PS # 6998

Survey Liber 1424, Page 569

11" Hickory N20deg.W 49.1'

6" Elm S60deg.E 36.0'

20" Elm Stump S65deg.E 7.2'

18" Elm Stump N30deg.E 4.7'

Atwell-Hicks, Inc., Date Unknown

Book 689, Page 29

20" Elm Stump S65deg.E 7.2'

18" Elm Stump N30deg.E 4.7'

Atwell-Hicks, Inc., 1984

Robert G. Macomber, PS #27453

Survey

Iron Pipe

Accessories same as December 1972, above