

APPROVED

DATE 11-20-96

CO. REF. Kx

LAND CORNER RECORDATION CERTIFICATE

Filing Requirement of Act 74, Mich, P.A. 1970

PEGGY M. HAINES
COUNTY CLERK/REGISTER

FEB 18 9 03 AM '97

RECORDED
WASHTENAW COUNTY, MI

For corner in	Located in:	Corner Code #
<u>Washtenaw</u> <small>(County)</small>		
1. Public Land Survey	T <u>2S</u> R <u>6E</u>	<u>G-11</u>
	T _____ R _____	_____
	T _____ R _____	_____
	T _____ R _____	_____
2. Property Controlling in Section	S _____ T _____ R _____	_____
	S _____ T _____ R _____	_____
3. Miscellaneous Property in Sec	S _____ T _____ R _____	_____
	S _____ T _____ R _____	_____

Liber 00001 Page 0581 RM

Register of Deeds Stamp & File Number

4. Lot No. _____, Recorded Plat _____
5. Private Claims _____

	A	B	C	D	E	F	G	H	I	J	K	L	M
1													
2	6	5	4	3	2	1							
3													
4	7	8	9	10	11	12							
5													
6	18	17	16	15	14	13							
7													
8	19	20	21	22	23	24							
9													
10	30	29	28	27	26	25							
11													
12	31	32	33	34	35	36							
13													

Charles C. Wilson, in a field survey on November 1, 1996, hereby certify that under requirements of P.A. 74, Michigan P.A. of 1970, the corner points mentioned in lines 1 and 2 above were in conformance with regulations and rules therefore as required in the current manual of survey instruction of the United States Department of the Interior, Bureau of Land Management or by a decree of a Court of Law and/or that the corner points mentioned in lines 3, 4 and 5 above were in conformance with the rules of the Michigan Board of Land Surveyors or by a Decree of a Court of Law; established, re-established, monumented, re-monumented, recovered, found as expressed below.

NOTE: Not more than 4 corners, all in the same town and range, may be recorded on this certificate.

Description of original monument and accessories and/or subsequent restoration:

United States Government Survey, 1815 Instructions, Surveyed 1819
Bearing Trees W. Oak 17" S12deg.W 23.76'
W. Oak 13" N11deg.W 15.18'
Meas. (N) 2640'
(S) 2640'
(E) 2591.16'

Continued on Back:

SURVEY & REMONUMENTATION

MAY 05 1997

COMMISSION

Description of corner evidence found and/or method applied in restoring or reestablishing corner:


Found 1" Iron Pipe surrounded with Stone from information and accessories mentioned in Paragraph A.

Description of monument for corner and accessories established to perpetuate locating the position of the corner:

Set Remonumentation Cap Stamped #13604 on top of existing 1" Iron Pipe.
0.7' NORTH of East-West Chain Link Fence
20" Hickory W'y 21.86' (Nail & RT S/S)
22" Oak N80deg.E 21.85' (Nail & RT S/S)
8" Pine N10deg.W 23.48' (Nail & RT E/S)
1" Iron Pipe, NW Corner of Lot 12, MALLORY ADDITION, Liber 2, Page 43, E'y 63.35'
1" Iron Pipe SW Corner of Lot 12, MALLORY ADDITION, Liber 2, Page 43, SE'y 91.7'
Back of Concrete Curb S'y 21.63'

* Indicates accessory previously mentioned in Paragraph A
RT Indicates Remonumentation Tag

I believe this point should be accepted as the best available evidence of the position of the original corner.
This point was ratified by the Washtenaw County Peer Committee on November 20, 1996.

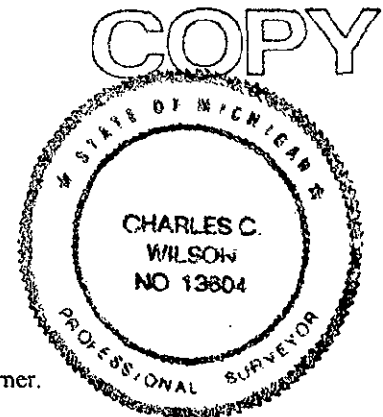

Signed by Charles C. Wilson
Surveyors Michigan's License No. 13604

Date November 21, 1996

Paragraph A Continued:

Plat of COLLEGE HILL, Liber 1, Page 30, June 12, 1891

Plat of MALLORY ADDITION, Liber 2, Page 43, April 18, 1912

Plat of DEVONSHIRE HEIGHTS SUBDIVISION, Liber 3, Page 31, January 8, 1923

Plat of BERKSHIRE HILLS SUBDIVISION, Liber 8, Page 35, August 16, 1929

Plat of BURSLEY-PATTERSON RESUBDIVISION, Liber 10, Page 16, January 26, 1943

Plat of L.A. WILSON'S SUBDIVISION, Liber 16, Page 16, March 1, 1962

Plat of RIVERSIDE HILLS SUBDIVISION NO. 2, Liber 17, Pages 25-26, October 20, 1964