

APPROVED
 DATE 11-20-96
 CO. REP. K/A

LAND CORNER RECORDATION CERTIFICATE
 Filing Requirement of Act 74, Mich, P.A. 1970

RECORDED
 WASHTENAW COUNTY, MI
 FEB 18 9 08 AM '97
 PEERY M. HAINES
 COUNTY CLERK/REGISTER

For corner in Washtenaw (County) Located in: Corner Code #

1. Public Land Survey	T <u>2S</u>	R <u>6E</u>	<u>I-12</u>
	T _____	R _____	_____
	T _____	R _____	_____
	T _____	R _____	_____
2. Property Controlling in Section	S _____	T _____	R _____
	S _____	T _____	R _____
3. Miscellaneous Property in Sec	S _____	T _____	R _____
	S _____	T _____	R _____

4. Lot No. _____, Recorded Plat _____

5. Private Claims _____

Liber 00001 Page 0599 pm
 Register of Deeds Stamp & File Number

	A	B	C	D	E	F	G	H	I	J	K	L	M
1													
2	6	5	4	3	2	1							
3													
4	7	8	9	10	11	12							
5													
6	18	17	16	15	14	13							
7													
8	19	20	21	22	23	24							
9													
10	30	29	28	27	26	25							
11													
12	31	32	33	34	35	36							
13													

I, Charles C. Wilson, in a field survey on November 1, 1996, do hereby certify that under requirements of P.A. 74, Michigan P.A. of 1970, the corner points mentioned in lines 1 and 2 above were in conformance with regulations and rules therefore as required in the current manual of survey instruction of the United States Department of the interior, Bureau of Land Management or by a decree of a Court of Law and/or that the corner points mentioned in lines 3, 4 and 5 above were in conformance with the rules of the Michigan Board of Land Surveyors or by a Decree of a Court of Law, established, re-established, monumented, re-monumented, recovered, found as expressed below.

NOTE: Not more than 4 corners, all in the same town and range, may be recorded on this certificate.

A. Description of original monument and accessories and/or subsequent restoration:

United States Government Survey, 1815 Instructions, Surveyed 1819
 Bearing Trees B. Oak 20" S8-1/2deg. W 26.40'
 W. Oak 21" N49deg. W 42.24'
 Meas. (N) 2640'
 (S) 2640'

Continued on Back:

SURVEY &
 REMONUMENTATION
 MAY 05 1997
 COMMISSION


B. Description of corner evidence found and/or method applied in restoring or reestablishing corner:

Found a 4" Diameter Concrete Monument with 3/4" Iron Pipe in center from information and accessories mentioned in Paragraph A.

C. Description of monument for corner and accessories established to perpetuate locating the position of the corner:

- 4" Diameter Concrete Monument with 3/4" Iron Pipe in center with Plastic Cap Stamped CCW #13604 in 3/4" Iron Pipe
- 22" Oak W'ly 39.45' (Nail & RT N/S) **
- 16" Oak S'ly 23.94' (Nail & RT E/S) **
- 15" Oak S40deg.E 12.04' (Nail & RT W/S) **
- 20" Oak S85deg.E 27.46' (Nail & RT S/S)
- 26" Oak N'ly 38.91' (Nail & RT W/S)
- NE Corner of Shed S75deg.W 26.4'

* Indicates accessory previously mentioned in Paragraph A
 RT Indicates Remonumentation Tag
 I believe this point should be accepted as the best available evidence of the position of the original corner.
 This point was ratified by the Washtenaw Count Peer Committee on November 20, 1996.

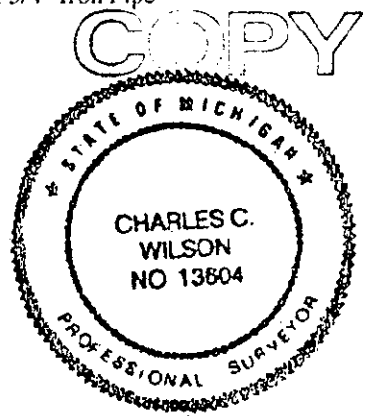

Signed by Charles C. Wilson
 Surveyors Michigan's License No. 13604

Date November 21, 1996

Paragraph A Continued:

Plat of ANN ARBOR HILLS, Liber 5, Pages 21-22, July 25, 1924

Plat of HUNTING VALLEY SUBDIVISION NO. 1, Liber 15, Page 15, February 23, 1960

Plat of WOODHAVEN HILLS, Liber 15, Pages 31-32, October 5, 1960

Plat of HUNTING VALLEY SUBDIVISION NO. 2, Liber 15, Page 47, March 27, 1961

Atwell-Hicks, Inc., July 20, 1977

Robert J. Jagow, PS #6998

Previous Land Corner Recordation Certificate, Liber 4, Page 288

Found Concrete Monument

18" Oak N85deg.W 39.3'

14" Oak N20deg.E 26.4'

22" Oak N18deg.E 39.6'

14" Oak S2deg.W 24.0'

12" Oak S45deg.E 12.3'

Washtenaw Engineering Co., Inc., 1980

Thomas L. Sutherland, PS #24620

Grid Book

3/4" Iron Pipe

20" Oak WEST 39.35' (Nail)

14" Oak N5deg.E 26.28' (Nail)

16" Oak S5deg.E 23.92' (Nail)

14" Oak S40deg.E 12.5' (Nail)

SURVEY &
REMONUMENTATION
MAY 05 1997
COMMISSION