

APPROVED
 DATE 11-20-96
 CO. REP. [Signature]

LAND CORNER RECORDATION CERTIFICATE
 Filing Requirement of Act 74, Mich, P.A. 1970

RECORDED
 WASHTENAW COUNTY, MI
 FEB 18 9 09 AM '97
 PEGGY M. HAINES
 COUNTY CLERK/REGISTER

For corner in Washtenaw (County) Located in: _____ Corner Code # _____

1. Public Land Survey	T	<u>2S</u>	R	<u>6E</u>	<u>J-9</u>
	T	_____	R	_____	_____
	T	_____	R	_____	_____
	T	_____	R	_____	_____
2. Property Controlling in Section	S	_____	T	_____	_____
	S	_____	T	_____	_____
3. Miscellaneous Property in Sec	S	_____	T	_____	_____
	S	_____	T	_____	_____

4. Lot No. _____, Recorded Plat _____

5. Private Claims _____

Liber 00001 Page 0601 *2m*

Register of Deeds Stamp & File Number

I, Charles C. Wilson, in a field survey on November 1, 19 96, do hereby certify that under requirements of P.A. 74, Michigan P.A. of 1970, the corner points mentioned in lines 1 and 2 above were in conformance with regulations and rules therefore as required in the current manual of survey instruction of the United States Department of the interior, Bureau of Land Management or by a decree of a Court of Law and/or that the corner points mentioned in lines 3, 4 and 5 above were in conformance with the rules of the Michigan Board of Land Surveyors or by a Decree of a Court of Law; established, re-established, monumented, re-monumented, recovered, found as expressed below.

	A	B	C	D	E	F	G	H	I	J	K	L	M
1													
2	6	5	4	3	2	1							
3													
4	7	8	9	10	11	12							
5													
6	18	17	16	15	14	13							
7													
8	19	20	21	22	23	24							
9													
10	30	29	28	27	26	25							
11													
12	31	32	33	34	35	36							
13													

NOTE: Not more than 4 corners, all in the same town and range, may be recorded on this certificate.

A. Description of original monument and accessories and/or subsequent restoration:

United States Government Survey, 1815 Instructions, Surveyed 1819
 Bearing Trees Hickory 8" S71deg.E 27.06'
 W. Oak 14" N14deg.W 12.54'
 Meas. (E) 2601.72'
 (W) 2601.72'

Continued on Back:

SURVEY &
 REMONUMENTATION

MAY 05 1997

COMMISSION


B. Description of corner evidence found and/or method applied in restoring or reestablishing corner:

Found 3/4" Iron Rod in Monument Box from information and accessories mentioned in Paragraph A.

C. Description of monument for corner and accessories established to perpetuate locating the position of the corner:

Re-set 3/4" Iron Rod with 1" x 18" Iron Pipe with Remonumentation Cap Stamped #13604
 Power Pole N45deg.E 72.08' (Nail & RT W/S) **
 Top Nut of Hydrant N60deg.E 55.00' **
 14" Hickory S45deg.E 55.12' (Nail & RT) **
 SW'ly Bolt in Light Pole Base N40deg.E 62.28' *
 20" Ash S60deg.W 55.12' (Nail & RT SE/S) *
 6" Locust N45deg.W 53.71' (Nail & RT SW/S)
 K-9, E'ly 2686.86' (Recorded as 2686.78') (Refer GLACIER HIGHLANDS SUB. NO. 4 and EARHART KNOWLS SUB. NO. 13604)
 * Indicates accessory previously mentioned in Paragraph A
 RT Indicates Remonumentation Tag
 I believe this point should be accepted as the best available evidence of the position of the original corner.
 This point was ratified by the Washtenaw County Peer Committee on November 20, 1996

COPY

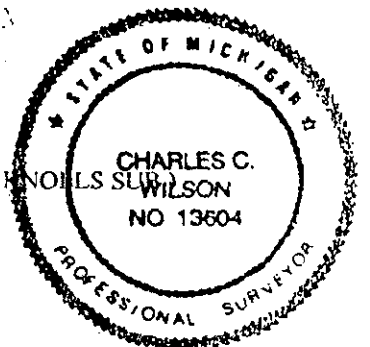

Signed by [Signature]
 Surveyors Michigan's License No. 13604

Date November 21, 1996

Paragraph A Continued:

H.H. Atwell, PS #322, Date Unknown
 Washtenaw County Road Commission Grid Book
 Found Stone
 Walnut 6" NE'y 44.0'
 Walnut 16" SE'y 26.2
 Maple 8" NW'y 54.2'

H.H. Atwell, PS #322, May 1926, December 1926, February 1950
 Survey Drawings

Atwell-Hicks, Inc., July 1964
 Howard Taft, PS #12032
 Grid Book and Book L, Page 12
 City of Ann Arbor Bench Mark Monument NE'y 41.3'

Washtenaw Engineering Co., Inc., 1966
 Allen R. Rentschler, PS #15411
 Survey Drawing, Found Iron Pipe
 16" Walnut SE'y 26.2' 12" Hickory N45deg.E 44.8'
 8" Maple NW'y 54.2' 8" Maple N40deg.W 35.2'

Plat of GLACIER HIGHLANDS SUBDIVISION NO.4, Liber 20, Pages 43-45, November 8, 1972

Atwell-Hicks, Inc., May 1973
 Grid Book
 R/W Iron Pipe S'y 33.0' Maple N60deg.W 67.2'
 Power Pole N45deg.E 72.7' 12" Hickory S45deg.E 55.4'
 Hydrant N60deg.E 55.4'

Washtenaw Engineering Co., Inc., May 17, 1977
 Norman N. Fahrner, PS #17620
 Previous Land Corner Recordation Certificate, Liber 4, Page 267, Found Iron Pipe
 16" Maple S'y 26.2' 12" Hickory N45deg.E 44.8'
 8" Maple NW'y 54.2' 8" Maple N40deg.W 35.2'

Washtenaw Engineering Co., Inc., September 21, 1977
 Thomas L. Sutherland, PS #24620
 Grid Book
 Found 1/2" Bar
 Top Nut of Hydrant N60deg.E 55.0' SW Bolt in Light Pole Base N40deg.E 62.3'
 12" Hickory S50deg.E 55.2' 12" Ash S60deg.W 55.1' (Nail)

Plat of EARHART KNOLLS SUBDIVISION, Liber 22, Pages 44-46, October 19, 1979

Plat of EARHART WEST, Liber 23, Pages 5-10, October 30, 1980

Plat of WATERHSED, Liber 23, Pages 59-61, April 1, 1982

Plat of THE WOODLANDS, Liber 25, Pages 10-12, March 30, 1987

Midwestern Consulting Inc., January 19, 1989
 Allen R. Rentschler, PS #15411
 Survey Drawing Job No. 88327
 Found Iron Rod in Monument Box
 Utility Pole N45deg.E 72.00'
 Utility Pole S40deg.W 55.15' (P.K. Nail)
 Utility Pole S45deg.E 68.00' (Nail & Washer)

SURVEY &
 REMONUMENTATION
 MAY 05 1997
 COMMISSION