

SURVEY & REMONUMENTATION

-copy-

MAY 09 1996

LAND CORNER RECORDATION CERTIFICATE
Filing Requirement of Act 74, Mich. P.A. 1970

For corners in **COMMISSION**
WASHTENAW
(County)

Located In: Corner Code #

1. Public Land Survey	T <u>2</u> S	R <u>6</u> E	<u>M-1</u>
	T	R	
	T	R	
	T	R	
2. Property Controlling in Section	S	T	R
	S	T	R
3. Miscellaneous Property in Sec.	S	T	R
	S	T	R

RECORDED
 WASHTENAW COUNTY, MI
 Mar 29 1 35 PM '96
 PERRY K. JAMES
 COUNTY CLERK/REGISTRAR
 -COPY-

Register of Deeds Stamp & File Number

4. Lot No. _____, Recorded Plat _____
 5. Private Claims _____

A	B	C	D	E	F	G	H	I	J	K	L
2	6		5		4		3		2		1
3											
4	7		8		9		10		11		12
5											
6	18		17		16		15		14		13
7											
8	19		20		21		22		23		24
9											
10	30		29		28		27		26		25
11											
12	31		32		33		34		35		36
13											

I, **I. JOHN JEKABSON**, in a field survey on 8 November, 19 95, do hereby certify that under requirements of P.A. 74, Michigan P.A. of 1970, the corner points mentioned in lines 1 and 2 above were in conformance with regulations and rules therefore as required in the current manual of survey instructions of the United States Department of the Interior, Bureau of Land Management or by a decree of a Court of Law and/or that the corner points mentioned in lines 3, 4 and 5 above were in conformance with the rules of the Michigan Board of Land Surveyors or by a Decree of a Court of Law; established, re-established, monumented, re-monumented, recovered, found as expressed below:

NOTE: Not more than 4 corners, all in the same town and range, may be recorded on this certificate.

A. Description of original monument and accessories and/or subsequent restoration:

1819 G.L.O. - SET POST Red Oak, 15" S 04° W 14Lks
 T. WAMPLER Hickory, 12" N 22° E 24Lks

Date Unknown WASHTENAW Iron Pipe
 COUNTY ROAD COMMISSION
 GRID BOOK - H.H. ATWELL

Maple, 6"	S 60° W	64.5	1
S.E. Cor. House	N.E.	168.75	2
N.E. Cor. House	S.E.	164.5	3
Hickory, 6"	N 62° W	54.1	4
Hickory, 10"	N 22½° W	68.9	5
Elm, 6"	N 31½° E	44.5	6


SEE BACK OF THIS SHEET (NEXT PAGE) FOR COMPLETE SECTION "A"

B. Description of corner evidence found and/or method applied in restoring or reestablishing corner:

FOUND 5/8" STEEL BAR IN MON BOX
 USING 4 WITNESSES FROM SECTION "A"

C. Description of monument for corner and accessories established to perpetuate locating the position of the corner:

Found 5/8" Steel Bar in Mon Box	PK & RT in SW sd Util. Pole	N 46° W	60.32	14
SET 1"x18" IRON PIPE W/REMON	SW Cor. House	N 44° E	145.34	11
CAP OVER THE STEEL BAR	Nail in 24" Apple	N 45° E	77.97	12
	PK & RT in S sd Util. Pole	N 80° E	142.46	15
	PK & RT in SW sd Util. Pole	S 60° E	122.46	16
	Nail in NE sd 12" Walnut	S 52° E	58.43	8
	PK & RT in SE sd 17" Elm	S 60° W	82.61	17

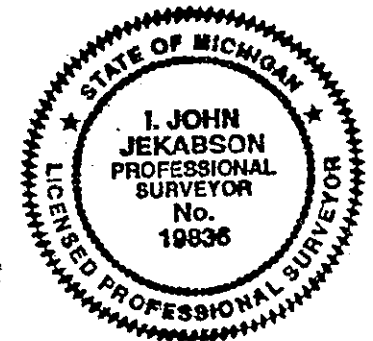

I conclude that after careful study of the record documentation and field observations, that this corner is accepted as the best available evidence of the position of the original corner.

Signed by I. John Jekabson Date 14 February, 1996
 Surveyor's Michigan License No. 19836

