

**SURVEY & REMONUMENTATION**

MAR 09 1998

RECORDED  
WASHTENAW COUNTY, MI

JAN 22 8 35 AM '98

**LAND CORNER RECORDATION CERTIFICATE**  
Filing Requirement of Act 74, Mich, P.A. 1970

PEGGY M. HAINES  
COUNTY CLERK/REGISTER

SECTION

For corner in	Located in:	Corner Code #
<u>Washtenaw</u> <small>(County)</small>		
1. Public Land Survey	T <u>2S</u> R <u>6E</u>	<u>M-5</u>
	T _____ R _____	_____
	T _____ R _____	_____
	T _____ R _____	_____
2. Property Controlling in Section	S _____ T _____ R _____	_____
	S _____ T _____ R _____	_____
3. Miscellaneous Property in Sec	S _____ T _____ R _____	_____
	S _____ T _____ R _____	_____
4. Lot No. _____, Recorded Plat _____		
5. Private Claims _____		

- COPY -

- COPY -

Liber 00002 Page 0101 RM  
Register of Deeds Stamp & File Number

I, Charles C. Wilson, in a field survey on August, 19 97, do hereby certify that under requirements of P.A. 74, Michigan P.A. of 1970, the corner points mentioned in lines 1 and 2 above were in conformance with regulations and rules therefore as required in the current manual of survey instruction of the United States Department of the interior, Bureau of Land Management or by a decree of a Court of Law and/or that the corner points mentioned in lines 3, 4 and 5 above were in conformance with the rules of the Michigan Board of Land Surveyors or by a Decree of a Court of Law; established, re-established, monumented, re-monumented, recovered, found as expressed below.

	A	B	C	D	E	F	G	H	I	J	K	L	M
1													
2	6	5	4	3	2	1							
3													
4	7	8	9	10	11	12							
5													
6	18	17	16	15	14	13							
7													
8	19	20	21	22	23	24							
9													
10	30	29	28	27	26	25							
11													
12	31	32	33	34	35	36							
13													

NOTE: Not more than 4 corners, all in the same town and range, may be recorded on this certificate.

**A. Description of original monument and accessories and/or subsequent restoration:**

United States Government, 1815 Instructions, Surveyed 1819  
Bearing Trees W. Oak 30" S27deg.E 34.98  
W. Oak 15" N33deg.W 30.36


Continued on Back

**B. Description of corner evidence found and/or method applied in restoring or reestablishing corner:**

Found 5/8" Iron Rod in Monument Box from remaining accessories mentioned in Paragraph A.  
Placed 3/4" x 3" Iron Pipe over Iron Rod with Remonumentation Cap Stamped #13604

**C. Description of monument for corner and accessories established to perpetuate locating the position of the corner:**

- 3/4" x 3" Iron Pipe over 5/8" Iron Rod with Remonumentation Cap Stamped #13604 in Monument Box
- (9) 18" Culvert N45deg.W 41.1
- (10) 18" Culvert S45deg.W 42.8
- (11) West end of 24" Culvert N34deg.W 49.7
- (12) East end of 24" Culvert N35deg.E 58.2
- (13) 16" Poplar N85deg.W 33.71 (Nail & RT S/S)
- (14) Iron Stake in Monument Box Nly 132.82 (Corner Code A-5, T2S, R7E)
- (15) 40" Oak S85deg.W 164.81 (Nail & RT N/S)
- (18) 10" Twin Cherry S28deg.W 69.44 (Nail & RT SE/S)
- (29) 12" Walnut S60deg.W 45.07 (Nail & RT SE/S)

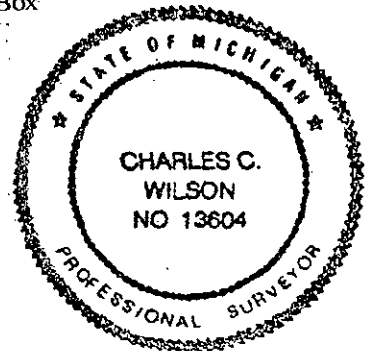

I feel that this point should be accepted as the best available evidence of the position of the original corner.  
This corner was ratified by the Peer Group on October 27, 1997.

Signed by Charles C. Wilson  
Surveyors Michigan's License No. 13604

Date October 28, 1997

APPROVED  
DATE 10/27/97  
CO. REP. K

- COPY -

## Paragraph A Continued:

S. Pettibone, 1850+-,

(1) 20" Elm N68deg.E 54.78

(2) 18" Elm S86deg.E 42.24

(3) 8" Hickory S65deg.W 25.08

H.H. Atwell, PS. #322, F. Soll, Crew Chief, Book 504, Page 18, August 8, 1925

Found 1" Iron Punch, Re-set with 4" x 48" Iron Pipe filled with concrete with 1" Iron Pipe in Top

(3) Stump S64deg.W 25.6

(4) 24" W. Oak S34deg.W 48.6

(5) 18" Elm S23deg.E 57.2

(6) 20" Forked Hickory 56.9

(7) 12" Elm S66-1/2deg.W 60.1

(8) 12" Cherry S13deg.E 84.6

Washtenaw County Road Commission, Grid Book, 1937+-

H.H. Atwell Iron Pipe

(4) 24" W. Oak S34deg.W 48.6

(5) 18" Elm S23deg.E 57.2

(6) 20" Forked Hickory 56.9

(7) 12" Elm S66-1/2deg.W 60.1

Atwell-Hicks, Inc.

Robert J. Jagow, PS# 6998, August 13, 1974

Previous Land Recordation Certificate, Liber 3, Page 585, Found 1" Steel Bar in Monument Box

(9) 18" Culvert N45deg.W 41.1

(10) 18" Culvert S45deg.W 42.8

(11) W. end 24" Culvert N34deg.W 49.7

(12) E. End 24" Culvert N35deg.E 58.2

Washtenaw Engineering Co., Inc.

Norman N. Fahrner, PS# 17620, December 17, 1975, Survey Drawing, Found 1/2" Steel Bar in Monument Box

(9) 18" Culvert N45deg.W 41.1

(10) 18" Culvert S45deg.W 42.8

(11) W. end 24" Culvert N34deg.W 49.7

(12) E. End 24" Culvert N35deg.E 58.2

Atwell-Hicks, Inc.

Robert Macomber, PS# 27453, February 9, 1983, Survey Drawing, Found 1/2" Bar in Monument Box

(13) 6" Poplar N85deg.E 33.8

(14) Monument North 132.8

(15) 38" Oak S80deg.W 164.0

(16) 36" Stump S70deg.W 114.5

McNamee, Porter &amp; Seely

Arvin N. Butterfield, PS# 21561, October 4, 1983,

Previous Land Recordation Certificate, Liber 6, Page 299, Found 1/2" Steel Bar in Monument Box

(9) 18" Culvert N45deg.W 41.1

(10) 18" Culvert S45deg.W 42.8

(11) W. end 24" Culvert N34deg.W 49.7

(12) E. End 24" Culvert N35deg.E 58.2

(13) 6" Poplar East 33.79

(17) Telephone Pole S24deg.E 65.74

(18) 8" Triple Cherry S35deg.W 69.45

(19) 6" Walnut S66deg.W 45.02

McNamee, Porter &amp; Seely

Arvin N. Butterfield, PS# 21561, November 29, 1983, Survey Drawing, Found 1/2" Steel Bar in Monument Box

This is a composite drawing of approximately 50 individual surveys.

(9) 18" Culvert N45deg.W 41.1

(10) 18" Culvert S45deg.W 42.8

(11) W. end 24" Culvert N34deg.W 49.7

(12) E. End 24" Culvert N35deg.E 58.2

(13) 6" Poplar East 33.79

(17) Telephone Pole S24deg.E 65.74

(18) 8" Triple Cherry S35deg.W 69.45

(19) 6" Walnut S66deg.W 45.02

McNamee, Porter &amp; Seely

Arvin N. Butterfield, PS# 21561, Donald J. Bendzinski, PS# 35989, 1983-1995

Survey Drawings (3+-), See Composite Drawing, Found 1/2" Steel Bar in Monument Box

(9) 18" Culvert N45deg.W 41.1

(10) 18" Culvert S45deg.W 42.8

(11) W. end 24" Culvert N34deg.W 49.7

(12) E. End 24" Culvert N35deg.E 58.2

(13) 6" Poplar East 33.79

(17) Telephone Pole S24deg.E 65.74

(18) 8" Triple Cherry S35deg.W 69.45

(19) 6" Walnut S66deg.W 45.02

Plat of FLEMING CREEK SUBDIVISION NO. 2, Liber 29, Pages 80-84, January 4, 1995