

SURVEY & REMONUMENTATION

RECORDED WASHTENAW COUNTY, MI

MAR 09 1998

JAN 22 8 35 AM '98

LAND CORNER RECORDATION CERTIFICATE

Filing Requirement of Act 74, Mich, P.A. 1970

PEGGY K. HAINES COUNTY CLERK/REGISTER

SECTION

For corner in

Washtenaw (County)

Located in:

Corner Code #

Table with 3 columns: Section description, Located in (T, R, S), and Corner Code #. Includes sections for Public Land Survey, Property Controlling in Section, and Miscellaneous Property in Sec.

4. Lot No. _____, Recorded Plat _____
5. Private Claims _____

I, Charles C. Wilson, in a field survey on August, 19 97, do hereby certify that under requirements of P.A. 74, Michigan P.A. of 1970, the corner points mentioned in lines 1 and 2 above were in conformance with regulations and rules therefore as required in the current manual of survey instruction of the United States Department of the interior, Bureau of Land Management or by a decree of a Court of Law and/or that the corner points mentioned in lines 3, 4 and 5 above were in conformance with the rules of the Michigan Board of Land Surveyors or by a Decree of a Court of Law; established, re-established, monumented, re-monumented, recovered, found as expressed below.

NOTE: Not more than 4 corners, all in the same town and range, may be recorded on this certificate.

A. Description of original monument and accessories and/or subsequent restoration:

United States Government, 1815 Instructions, Surveyed 1819
Bearing Trees B. Oak 20" N88deg.W 112.50
W. Oak 18" S42deg.W 124.74

Continued on Back

B. Description of corner evidence found and/or method applied in restoring or reestablishing corner:

Found 4" Iron Pipe filled with concrete with 1" Iron Pipe in center from remaining accessories mentioned in Paragraph A. Placed Remonumentation Cap Stamped #13604 over 1" Iron Pipe.

C. Description of monument for corner and accessories established to perpetuate locating the position of the corner:

- 1" Iron Pipe in Concrete with Remonumentation Cap Stamped #13604 (at grade)
(4) 18" Elm S30deg.W 88.8
(5) 10" Dead Elm N30deg.W 77.2
(7) 12" Dead Tamarack N44deg.E 14.81 (Nail & RT NW/S)
(11) 12" Dead Tamarack S70deg.E 17.61 (Nail & RT NW/S)
(12) 12" Dead Tamarack S42deg.E 16.36 (Nail & RT NW/S)
12" Dead Tamarack S28deg.W 41.53 (Nail W/S)


I feel that this point should be accepted as a careful and faithful perpetuation of the position of the original corner. This corner was ratified by the Peer Group on October 27, 1997.

Signed by [Signature] Surveyors Michigan's License No. 13604

Date October 28, 1997

Liber 00002 Page 0105 RM
Register of Deeds Stamp & File Number

Grid table with columns A-M and rows 1-13. Contains numbers 1-36 in a grid pattern.

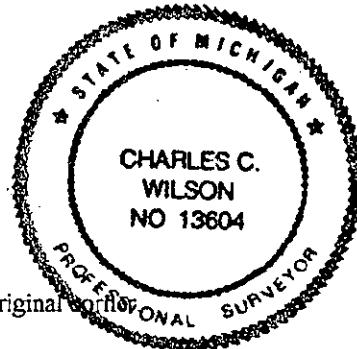

APPROVED
DATE 10/27/97
CO. REF. KA

- COPY -

Paragraph A Continued:

S. Pettibone, 1850+-
20" W. Oak S52-1/3deg.W 124.08

Professor J.B. Davis, 1895, Book F, Page 66
Found sharpened Wood Stake in Marsh. Put in 5" x 5" Round Oak Tree Stake with Bark on it. Also set 1" x 27"
Round Solid Iron Rod with 3" x 5" Iron Keyed onto it at N/S of stake and 2 bricks South of stake.
(1) 12" Tamarack NE'ly 96.8 (2) 12" Tamarack SE'ly 103.13

H.H. Atwell, PS# 322, F. Soll, Crew Chief, August 25, 1925, Book 514, Page 14
Replaced 5" x 5" Round Oak Tree Stake with 4" x 48" Iron Pipe filled with concrete with 1" Iron Pipe in middle

Washtenaw County Road Commission, W.J. Armstrong, PS# 2444, August 15, 1935, Grid Book
Found 4" Iron Pipe. Placed 4 bricks around it.
(2) 14" Tamarack S70deg.E 104.5 (3) 18" Tamarack S80deg.E 117.5 (4) 6" Elm S30deg.W 88.8
(5) 5" Elm N30deg.W 77.2

Washtenaw Engineering Co., Inc., Norman N. Fahrner, PS# 17620, October 3, 1978
Previous Land Recordation Certificate, Liber 5, page 99, Found 4" Iron Pipe reduced to 1" Iron Pipe
(6) 20" Twin Elm N30deg.W 70.0 (7) 20" Tamarack North 14.75 (8) 20" Tamarack N30deg.E 17.62
(9) 8" Ash S30deg.W 40.0 (10) 10" Elm N80deg.W 39.45

Atwell-Hicks, Inc., John L. Synder, PS# 13352, March 1, 1980
Previous Land Recordation Certificate, Liber 5, Page 333
Found 4" Iron Pipe filled with concrete with 1" Iron Pipe inserted in top end
(6) 16" Twin Basswood N40deg.W 71.4
(7) 14" Tamarack N40deg.E 14.7 (10) 8" Elm West 39.6 (11) 10" Tamarack S70deg.E 17.9
(12) 8" Tamarack S30deg.E 16.3

McNamee, Porter & Seely, Arvin N. Butterfield, PS# 21561, January 27, 1981
Previous Land Recordation Certificate, Liber 6, Page 127, Found 4" Iron Pipe reduced to 1" Iron Pipe
(6) 18" Twin Elm N40deg.W 72.1 (7) 12" Tamarack N30deg.E 14.75 (10) 8" Elm N80deg.W 39.4
(11) 12" Tamarack S60deg.E 17.60 (12) 8" Tamarack S30deg.E 16.4




McNamee, Porter & Seely
Arvin N. Butterfield, PS# 21561, Donald J. Bendzinski, PS# 35989, 1983-1995
Survey Drawings (6+-), See Composite Drawing, Found 4" Iron Pipe reduced to 1" Iron Pipe
This is a composite drawing of approximately 50 individual surveys.
(6) 18" Twin Elm N40deg.W 72.1 (7) 12" Tamarack N30deg.E 14.75 (10) 8" Elm N80deg.W 39.4
(11) 12" Tamarack S60deg.E 17.60 (12) 8" Tamarack S30deg.E 16.4
Revised and Additional Accessories
(6) 20" Twin Elm N40deg.W 72.01 (7) 12" Tamarack N30deg.E 14.86 (10) 16" Elm N80deg.W 39.61
(11) 12" Tamarack S60deg.E 17.46 (12) 12" Tamarack S30deg.E 16.31