

SURVEY & REMONUMENTATION

- Copy -

MAY 09 1996

LAND CORNER RECORDATION CERTIFICATE
Filing Requirement of Act 74, Mich. P.A. 1970

For corners
COMMISSION
Washtenaw
(County)

Located In: Corner Code #

1. Public Land Survey	T 2S R 6E	M 9
	T R	
	T R	
	T R	
2. Property Controlling in Section	S T R	
	S T R	
3. Miscellaneous Property in Sec.	S T R	
	S T R	

- Copy -

PERGEE & JAMES
COUNTY CLERK & REGISTER

MAR 29 1 44 PM '96

RECORDED
WASHTENAW COUNTY, MI

Register of Deeds Stamp & File Number

4. Lot No. _____, Recorded Plat _____
5. Private Claims _____

Patrick Hastings in a field survey on June 23, 1995, do hereby certify that under requirements of P.A. 74, Michigan P.A. of 1970, the corner points mentioned in lines 1 and 2 above were in conformance with regulations and rules therefore as required in the current manual of survey instructions of the United States Department of the Interior, Bureau of Land Management or by a decree of a Court of Law and/or that the corner points mentioned in lines 3, 4 and 5 above were in conformance with the rules of the Michigan Board of Land Surveyors or by a Decree of a Court of Law; established, re-established, monumented, re-monumented, recovered, found as expressed below:

A	B	C	D	E	F	G	H	I	J	K	L	I
2	6	5	4	3	2	1						
3												
4	7	8	9	10	11	12						
5												
6	16	17	16	15	14	13						
7												
8	19	20	21	22	23	24						
9												
10	30	29	28	27	26	25						
11												
12	31	32	33	34	35	36						
13												

NOTE: Not more than 4 corners, all in the same town and range, may be recorded on this certificate.


A. Description of original monument and accessories and/or subsequent restoration:

- 1819 Township boundary G.L.O. by J. Wampler, P.S.
Set Post
1) N 11° W 26 lks W.O. 15"
2) S 22° E 52 lks W.O. 24"
- 1840 From field notes, Book OBD-D, Pg. 83-84 from Atwell Hicks, Inc.
Oak stake and buried stones
3) N 70° W? 28.5' W. Oak 7"
4) S 12° E? 18.2' W. Oak 5"
5) North 186.0' Stake said to be S.W. Cor. Sec. 19 T2S, R7E

(SECTION A CONTINUED)

B. Description of corner evidence found and/or method applied in restoring or reestablishing corner:

- Found 1" iron pipe surrounded with buried rocks, from above remaining witnesses
- 4) S 12° E 18.70' W. Oak 18"
- 5) North 186.47' S.W. corner Sec. 19 T2S-R7E #24818, 1870, TP w/rock on surface
- 6) S.W. 7.00' W. Oak 10"
- 7) N.E. 28.00' W. Oak 18"
- 8) S.W. 19.3' Dead Fall 18" B. Oak
- 9) N 20° E 9.0' Dead Fall 7" Ash
- 10) N 20° W 11.36' Shagbark Hickory
- 11) N 30° E 15.93' Ash 8"

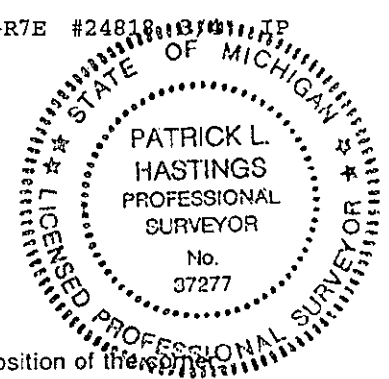

C. Description of monument for corner and accessories established to perpetuate locating the position of the corner:

- 1" iron pipe with std. Wash. Co. Remon cap stamped #37277 surrounded with buried rocks
- 4) S 12° E 18.7' W. Oak 18" - Set PK & RT S.E./S
- 5) North 186.0' W 1/4 corner for 19 and 30 T2S, R7E
- 6) S.W. 7.00' W. Oak 10" - Set PK & RT W/S
- 7) N.E. 28.0' W. Oak 18" - Set PK & RT S/S
- 10) N 20° W 11.36' Shagbark Hickory - Set PK & RT
- 11) N 30° E 15.93' Ash 8" - Set PK & RT SE/S

Signed by Patrick L. Hastings Date 11/15/95
Surveyor's Michigan License No. 37277

- Copy -

1930s W.C.R.C. Gridbook Atwell-Hicks, Inc.

Iron pipe

- 4) S 12° E 18.7' W. Oak 10"
- 5) North 186.0' NW corner for Section 30 T2S, R7E
- 6) S.W. 7.1' W. Oak 7"
- 7) N.E. 28.1' W. Oak 10"
- 8) S.W. 19.3' B. Oak 12"

1958 Compiled survey drawing from Atwell Hicks, Inc.

- 4) S 12° E 18.7' W. Oak 10"
- 6) S.W. 7.1' W. Oak 7"
- 7) N.E. 28.1' W. Oak 10"
- 8) S.W. 19.3' B. Oak 12"

1980 L.C.R.C. by John Litchfield Snyder #13352, L. 5, pg. 334

Found 1" iron pipe and all of the above witness trees

- 4) S 12° E 18.7' W. Oak 16"
- 5) North 186.41' S.W. Cor. Sec. 19, T2S, R7E
- 6) S.W. 7.1' W. Oak 10"
- 7) N.E. 28.0' W. Oak 16"
- 8) S.W. 19.3' B. Oak 18"
- 9) N 30° E 9.0' Ash 7"
- 10) N 20° W 11.1' Shagbark Hickory 12"

APPROVED
 DATE 10/9/95
 CO. REP. *fx*