

SURVEY & REMONUMENTATION

MAY 05 1997

COMMISSION

LAND CORNER RECORDATION CERTIFICATE
Filing Requirement of Act 74, Mich. P.A. 1970

copy
RECORDED
WASHTENAW COUNTY, MI
MAR 29 1 34 PM '96
PEGGY A. DAVIS
COUNTY CLERK/REGISTER

For corners in
WASHTENAW
(County)

Located In: Corner Code #

- 1. Public Land Survey T 2 S R 7 E A - 1
- T _____ R _____
- T _____ R _____
- T _____ R _____
- 2. Property Controlling S _____ T _____ R _____
in Section S _____ T _____ R _____
3. Miscellaneous S _____ T _____ R _____
Property in Sec. S _____ T _____ R _____

Seg # 2 gm

Register of Deeds Stamp & File Number

- 4. Lot No. _____, Recorded Plat _____
- 5. Private Claims _____

	A	B	C	D	E	F	G	H	I	J	K
2	6		5		4		3		2		
3											
4	7		8		9		10		11		
5											
6	18		17		16		15		14		
7											
8	19		20		21		22		23		
9											
10	30		29		28		27		26		
11											
12	31		32		33		34		35		
13											

I, I. JOHN JEKABSON, in a field survey on 8 November, 19 95, do hereby certify that under requirements of P.A. 74, Michigan P.A. of 1970, the corner points mentioned in lines 1 and 2 above were in conformance with regulations and rules therefore as required in the current manual of survey instructions of the United States Department of the Interior, Bureau of Land Management or by a decree of a Court of Law and/or that the corner points mentioned in lines 3, 4 and 5 above were in conformance with the rules of the Michigan Board of Land Surveyors or by a Decree of a Court of Law; established, re-established, monumented, re-monumented, recovered, found as expressed below:

NOTE: Not more than 4 corners, all in the same town and range, may be recorded on this certificate.

A. Description of original monument and accessories and/or subsequent restoration:

1819 G.L.O. - SET POST Red Oak, 15" S 04° W 14Lks
T. WAMPLER Hickory, 12" N 22° E 24Lks

Date Unknown	WASHTENAW	Iron Pipe	Maple, 6"	S 60° W	64.5	1
COUNTY ROAD COMMISSION			S.E. Cor. House	N.E.	168.75	2
GRID BOOK - H.H. ATWELL			N.E. Cor. House	S.E.	164.5	3
			Hickory, 6"	N 62° W	54.1	4
			Hickory, 10"	N 22½° W	68.9	5
			Elm, 6"	N 31½° E	44.5	6


SEE BACK OF THIS SHEET (NEXT PAGE) FOR COMPLETE SECTION "A"

B. Description of corner evidence found and/or method applied in restoring or reestablishing corner:

FOUND 5/8" STEEL BAR IN MON BOX
USING 4 WITNESSES FROM SECTION "A"

C. Description of monument for corner and accessories established to perpetuate locating the position of the corner:

Found 5/8" Steel Bar in Mon Box	PK & RT in SW sd Util. Pole	N 46° W	60.32	14
SET 1"X18" IRON PIPE W/REMON	SW Cor. House	N 44° E	145.34	11
CAP OVER THE STEEL BAR	Nail in 24" Apple	N 45° E	77.97	12
	PK & RT in S sd Util. Pole	N 80° E	142.46	15
	PK & RT in SW sd Util. Pole	S 60° E	122.46	16
	Nail in NE sd 12" Walnut	S 52° E	58.43	8
	PK & RT in SE sd 17" Elm	S 60° W	82.61	17

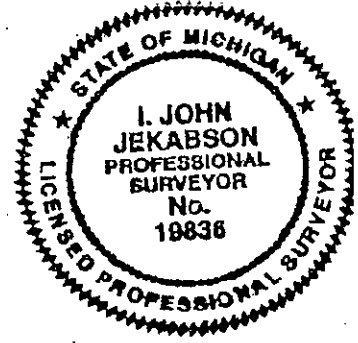

I conclude that after careful study of the record documentation and field observations, that this corner is accepted as the best available evidence of the position of the original corner.

Signed by I. John Jekabson Date 14 February, 1996
Surveyor's Michigan License No. 19836

APPROVED
DATE 11-13-95
CO. REP M

1995 WASHTENAW COUNTY REMONUMENTATION PROGRAM

SUPERIOR TOWNSHIP TOWN 2 SOUTH, RANGE 7 EAST
 A-1 (NORTHWEST CORNER OF SECTION 6)

History compiled by:
 I. John Jekabson P.S. # 19836
 Roskelly, Jekabson & Assoc. P.C.

DATE	COMPANY SURVEYOR & JOB #	P.S. #	P.A. 74 L.C.R.C.	LOCATION OF SURVEY	MONUMENT DESCRIPTION	WITNESSES	BEARING & DISTANCE	ID #	COMMENT
1819	G.L.G. T. WAMPLER				Set post	Red Oak, 15" Hickory, 12"	S 04° W 14Lks N 22° E 24Lks		
Unknown	WASHTENAW COUNTY ROAD COMMISSION Grid-Book H.H. ATWELL				Iron Pipe	Maple, 6" S.E. Cor. House N.E. Cor. House Hickory, 6" Hickory, 10" Elm, 6"	S 60° W 64.5 N.E. 168.75 S.E. 164.5 N 62° W 54.1 N 22½° W 68.9 N 31½° E 44.5	1 2 3 4 5 6	
1956	ATWELL - HICKS, INC. Job # 5231			S.E. 1/4 OF SECTION 36	Found Iron	No Witnesses			
14 Jan. 1959	ATWELL-HICKS, INC. Job # 7478			S.E. 1/4 OF SECTION 36	No Indication	No Witnesses			
24 July 1961	DETROIT EDISON CO. J. SIERGIEJ			LARK CORRIDOR	Found Iron	No Witnesses			
10 Nov.	Drawing # SMS-894-2								
1966	WASHTENAW COUNTY ROAD COMMISSION Grid-Book R.B. (hand written)					E. Pole to nail 9" Walnut to nail T. Pole to nail RAW Pipe	N 46° W 58.63 S 52° E 58.70 S 22° E 59.65 S 52° W 47.20	7 8 9 10	
1972	WASHTENAW ENG. CO. NORMAN N. FAHRNER	#47620	Liber 2, Page 447	A-1 (NW corner Section 1) T.2S., R.7E.,	Found Monument Box	SW Cor. House NE Cor. House 24" Apple 24" Apple	NE 145.7 SE 164.5 N 45° E 80.6 N 50° E 102.0	11 3 12 13	
1994	MIDWESTERN CONSULTING Job # 94285			S. 1/2 of Section 36	No Indication	No witnesses			

00001
 0449
 00001