

SECTION

LAND CORNER RECORDATION CERTIFICATE
Filing Requirement of Act 74, Mich; P.A. 1970

For corner in

Washtenaw
(County)

Located in:

Corner Code #

1. Public Land Survey

T 2S R 7E

E-10

2. Property Controlling in Section

S T R
S T R

3. Miscellaneous Property in Sec

S T R
S T R

4. Lot No. Recorded Plat

5. Private Claims



5094766
Page: 1 of 2
02/07/2000 02:55P

Register of Deeds Stamp & File Number

I, Charles C. Wilson, in a field survey on September, 19 99, do hereby state that under requirements of P.A. 74, Michigan P.A. of 1970, the corner points mentioned in lines 1 and 2 above were in conformance with regulations and rules therefore as required in the current manual of survey instruction of the United States Department of the interior, Bureau of Land Management or by a decree of a Court of Law and/or that the corner points mentioned in lines 3, 4 and 5 above were in conformance with the rules of the Michigan Board of Land Surveyors or by a Decree of a Court of Law; established, re-established, monumented, recovered, found as expressed below.

NOTE: Not more than 2 corners, all in the same town and range, may be recorded on this certificate.

Grid table with columns A-M and rows 1-13. Cell (10, D) contains a small circular symbol.

A. Description of original monument and accessories and/or subsequent restoration:

United States Government Survey, 1815 Instructions, Surveyed 1819, Joseph Wampler, D.S.
Bearing Trees A) Lynn 9" S85deg.E 7.92
B) W. Oak 21" N62deg.W 21.78


Continued on Back

B. Description of corner evidence found and/or method applied in restoring or reestablishing corner:

Found 1/2" Iron Pipe inside a 1-1/4" Iron Pipe, 3 feet West of centerline of gravel on LeForge Road, 0.5 below gravel surface

C. Description of monument for corner and accessories established to perpetuate locating the position of the corner:

Installed Remonumentation Cap on existing 1/2" Iron Pipe, 0.5 below gravel surface
Previous Accessory 7) 30" Oak S35deg.W 42.84 Nail and RT W/S
Previous Accessory 8) 40" Twin Oak S45deg.W 33.24 Nail and RT E/S
Previous Accessory 9) 38" Oak W'y 54.02 Nail and RT N/S
Previous Accessory 11) 1/2" Iron Pipe E'y 33.04
Previous Accessory 12) 1/2" Iron Pipe W'y 33.03
Previous Accessory 13) 28" Hickory S45deg.E 45.22 Nail and RT W/S
New Accessory 3/4" Iron Pipe E'y 43.05

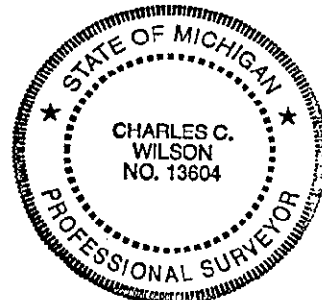

I find no evidence to conflict with the acceptance of this point as being the best available evidence for the position of this corner. This point was ratified by the Washtenaw County Peer Committee on November 15, 1999.

Signed by [Signature]
Surveyors Michigan's License No. 13604

Date November 15, 1999

APPROVED
DATE 11/15/99
CO. REP. [Signature]

REM

SEARCHED

MAR 10 2000

SECTION

- Copy -



5094766
Page: 2 of 2
02/07/2000 02:55P

Paragraph A Continued

Peggy M. Haines - Washtenaw Co. CORREM L-3 P-46

- 1870+ Pettibone's Witness Book on file at Atwell-Hicks, Inc.
 - 1) 12" WO N84-3/4deg.W 88.44
 - 2) 9" Elm S51deg.W 32.34
 - 3) 3" Hickory N76-3/4deg.E 58.74
 - 4) 20" WO S40deg.W 82.50

- Nov. WCRC Grid Book, WJ Armstrong
- 1934 Found Old Wood Stake, re-set with 1-1/2" Iron pipe, stones and bricks
 - 5) 36" B. Cherry N84deg.E 88.3
 - 6) 12" Elm S25deg.E 72.0
 - 7) 12" Burr Oak S32deg.W 43.2
 - 8) 24" Twin Burr Oak S43deg.W 33.7
 - 9) 28" Burr Oak S88deg.W 54.5
 - 10) 16" Maple N35deg.W 42.3
 - 11) Iron Pipe E'ly 33.0
 - 12) Iron Pipe W'ly 33.0

- April Robert Campbell, PS #13208
- 1977 LCRC, Liber 4, Page 197
 - Found 1-1/4" Iron Pipe with 1/2" Iron Pipe on top
 - 7) 27" Burr Oak S35deg.W 43.24
 - 8) 38" Twin Burr Oak S45deg.W 33.25
 - 9) 34" Burr Oak N90deg.W 54.62
 - 11) Iron Pipe E'ly 33.08
 - 12) Iron Pipe W'ly 33.07
 - 13) 24" Hickory S45deg.E 45.67