

RFM

2000

SECTION

LAND CORNER RECORDATION CERTIFICATE  
Filing Requirement of Act 74, Mich, P.A. 1970

For corner in  
Washtenaw  
(County)

Located in:

Corner Code #

1. Public Land Survey

T 2S R 7E  
T \_\_\_\_\_ R \_\_\_\_\_  
T \_\_\_\_\_ R \_\_\_\_\_  
T \_\_\_\_\_ R \_\_\_\_\_

E-11


*Copy*

2. Property Controlling  
in Section

S \_\_\_\_\_ T \_\_\_\_\_ R \_\_\_\_\_  
S \_\_\_\_\_ T \_\_\_\_\_ R \_\_\_\_\_

3. Miscellaneous  
Property in Sec

S \_\_\_\_\_ T \_\_\_\_\_ R \_\_\_\_\_  
S \_\_\_\_\_ T \_\_\_\_\_ R \_\_\_\_\_

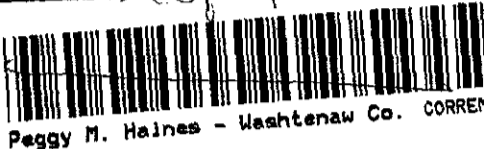

5094767  
Page: 1 of 2  
02/07/2000 02:55P  
L-3 P-47

Register of Deeds Stamp & File Number

4. Lot No. \_\_\_\_\_, Recorded Plat \_\_\_\_\_  
5. Private Claims \_\_\_\_\_

I, Charles C. Wilson, in a field survey on September, 19 99, do hereby state that under requirements of P.A. 74, Michigan P.A. of 1970, the corner points mentioned in lines 1 and 2 above were in conformance with regulations and rules therefore as required in the current manual of survey instruction of the United States Department of the interior, Bureau of Land Management or by a decree of a Court of Law and/or that the corner points mentioned in lines 3, 4 and 5 above were in conformance with the rules of the Michigan Board of Land Surveyors or by a Decree of a Court of Law, established, re-established, monumented, recovered, found as expressed below.

NOTE: Not more than 2 corners, all in the same town and range, may be recorded on this certificate.

	A	B	C	D	E	F	G	H	I	J	K	L	M
1													
2	6		5		4		3		2				
3													
4	7		8		9		10		11		12		
5													
6	18		17		16		15		14		13		
7													
8	19		20		21		22		23		24		
9													
10	30		29		28		27		26		25		
11													
12	31		32		33		34		35		36		
13													

A. Description of original monument and accessories and/or subsequent restoration:

United States Government Survey, 1815 Instructions, Surveyed 1819, Joseph Wampler, D.S.  
Bearing Trees A) Hickory 8" S28deg.W 21.12  
B) Hickory 9" N33deg.W 1.98


Continued on Back

B. Description of corner evidence found and/or method applied in restoring or reestablishing corner:

Found 1" Iron Pipe 0.7 below bituminous surface 2 feet north of centerline of Geddes Road and on centerline of LeForge Road.

C. Description of monument for corner and accessories established to perpetuate locating the position of the corner:

Set 1/2" Iron Rod with Remonumentation Cap inside existing 1" Iron Pipe 0.7 feet below bituminous surface  
Previous Accessory 11) Top of Hydrant S50deg.E 84.07  
Previous Accessory 12) Utility Pole N40deg.W 45.39 Nail and RT SW/S  
Previous Accessory 13) Utility Pole S35deg.W 56.52 Nail and RT NW/S  
Previous Accessory 14) Metal Fence Post N45deg.E 47.0

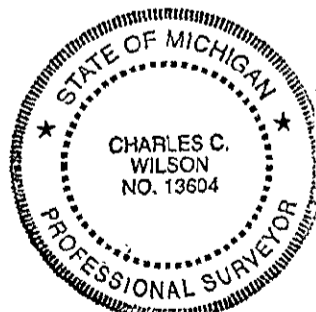

I find no evidence to conflict with the acceptance of this point as being the best available evidence for the position of this corner. This point was ratified by the Washtenaw County Peer Committee on November 15, 1999. Washtenaw County Road Commission will install monument box at a later date.

Signed by Charles C. Wilson  
Surveyors Michigan's License No. 13604

Date November 15, 1999

APPROVED  
DATE 11/15/99  
CO. REP. Kx

REN.

SURVEY

MAY 2000

SECTION

Paragraph A Continued

- 1870+- Pettibone's Witness Book on file at Atwell-Hicks, Inc.  
1) 30" B. Walnut S40deg.W 55.44  
2) 10" Butternut S76deg.E 84.48



5094767  
Page: 2 of 2  
02/07/2000 02:55P  
L-3 P-48

Peggy M. Haines - Washtenaw Co. CORREM

- May WCRC Grid Book, WJ Armstrong  
1934 Found traces of old wood stake with stone beside it. Set 1-1/2" x 36" Iron Pipe, stones & bricks.  
3) 40" Elm N24-1/2deg.W 72.3  
4) 8" Elm N29-1/2deg.E 53.0  
5) NE corner hdwl N73deg.E 33.85  
6) SE corner hdwl S63-1/2deg.E 35.75  
7) Iron Pipe NE 46.7  
8) Iron Pipe SE 46.5  
9) Iron Pipe SW 46.9  
10) Iron Pipe NW 46.3

- Jan. WCRC Survey Drawing  
1936 3) 40" Elm N24deg.W 72.3  
4) 8" Elm N29deg.E 53.0  
5) NE corner hdwl N73deg.E 33.8  
6) SE corner hdwl S63deg.E 35.7

- August C. Wilson & Associates, Inc.  
1991 Charles C. Wilson, PS #13604  
Survey Drawing  
Found 1/2" Iron Pipe  
11) Top of Hydrant S50deg.E 84.07  
12) Utility Pole N40deg.W 44.65  
13) Utility Pole S35deg.W 56.22  
14) Metal Fence Post N45deg.E 46.92