

REM

02/07/2000

SECTION

LAND CORNER RECORDATION CERTIFICATE  
Filing Requirement of Act 74, Mich, P.A. 1970

For corner in

Washtenaw  
(County)

Located in:

Corner Code #

1. Public Land Survey

T 2S R 7E

E-12

2. Property Controlling  
in Section

S T R  
S T R

3. Miscellaneous  
Property in Sec

S T R  
S T R

4. Lot No.

Recorded Plat

5. Private Claims



5094768  
Page: 1 of 2  
02/07/2000 02:55P

Peggy M. Haines - Washtenaw Co. CORREM L-3 P-49

Register of Deeds Stamp & File Number

I, Charles C. Wilson, in a field survey on September, 19 99, do hereby state that under requirements of P.A. 74, Michigan P.A. of 1970, the corner points mentioned in lines 1 and 2 above were in conformance with regulations and rules therefore as required in the current manual of survey instruction of the United States Department of the interior, Bureau of Land Management or by a decree of a Court of Law and/or that the corner points mentioned in lines 3, 4 and 5 above were in conformance with the rules of the Michigan Board of Land Surveyors or by a Decree of a Court of Law; established, re-established, monumented, recovered, found as expressed below.

NOTE: Not more than 2 corners, all in the same town and range, may be recorded on this certificate.

	A	B	C	D	E	F	G	H	I	J	K	L	M
1													
2	8		5		4		3		2		1		
3													
4	7		8		9		10		11		12		
5													
6	18		17		16		15		14		13		
7													
8	19		20		21		22		23		24		
9													
10	30		29		28		27		26		25		
11													
12	31		32		33		34		35		36		
13													

A. Description of original monument and accessories and/or subsequent restoration:

United States Government Survey, 1815 Instructions, Surveyed 1819, Joseph Wampler, D.S.  
Bearing Trees A) W. Oak 21" S75deg.E 31.02  
B) Hickory 18" N81deg.W 31.02

Continued on Back


B. Description of corner evidence found and/or method applied in restoring or reestablishing corner:

Found 1-1/2" Iron Pipe 2 feet below bituminous surface on LeForge Road.

C. Description of monument for corner and accessories established to perpetuate locating the position of the corner:

Set 3/4" Iron Pipe and Remonumentation Cap over existing 1-1/2" Iron Pipe. Installed new monument box.  
Previous Accessory 5) 34" Walnut S25deg.E 78.00 Nail and RT W/S  
Previous Accessory 8) 20" Hickory S22deg.W 90.05 Nail and RT E/S  
Previous Accessory 12) 24" Ash S85deg.E 33.03 Nail and RT N/S  
Previous Accessory 13) 18" Ash S72deg.E 31.70 Nail and RT N/S  
Previous Accessory 14) 18" Boxelder S80deg.W 33.63 Nail and RT N/S  
Previous Accessory 17) 24" Elm N30deg.E 40.65 Nail and RT N/S  
New Accessory 15" Elm S65deg.W 21.18 Nail and RT N/S  
New Accessory 18" Boxelder N65deg.E 25.80 Nail and RT W/S

I find no evidence to conflict with the acceptance of this point as being the best available evidence for the position of this corner.  
This point was ratified by the Washtenaw County Peer Committee on November 15, 1999.

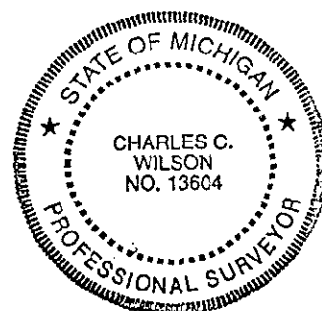

Signed by

*Charles C. Wilson*

Surveyors Michigan's License No.

13604

Date

November 15, 1999

APPROVED

DATE 11/15/99

CO. REP. *K*

2000

## SECTION



5094768  
Page: 2 of 2  
02/07/2000 02:55P

Peggy M. Haines - Washtenaw Co. CORREM L-3 P-50

## Paragraph A Continued

- 1870+- Pettibone's Witness Book on file at Atwell-Hicks, Inc.  
1) 2" Apple S66deg.E 53.46  
2) 4" B. Walnut N84deg.W 43.56
- May WCRC Grid Book, WJ Armstrong  
1934 Found 2 old wood stakes and stones. Set 1-1/2" x 48" Iron Pipe, stones and bricks  
2) 28" B. Walnut N83-1/2deg.W 44.5  
3) 30" B. Walnut N15deg.W 115.9  
4) 40" Elm S51deg.E 43.4  
5) 24" B. Walnut S24deg.E 78.8  
6) Iron Pipe E'ly 33.0  
7) Iron Pipe W'ly 33.0
- March WCRC Grid Book, Book 147, Page 129, WJ Armstrong  
1940 8) 8" Hickory S22deg.W 90.3  
9) 2" Elm S30deg.W 41.0  
10) 6" W. Oak N89-1/2deg.W 124.2  
11) 3" Elm N55deg.W 24.7  
12) 5" Ash S83deg.E 33.7  
13) 3" Ash S72-1/2deg.E 32.1
- March Midwestern Consulting Inc.  
1976 Survey Drawing  
Found 1-1/2" Iron Pipe  
5) 30" B. Walnut S24deg. E 78.2  
8) 12" Hickory S22deg.E 90.4  
12) 10" Ash S83deg.E 33.6  
13) 8" Ash S72deg.E 31.9
- March Midwestern Consulting Inc.  
1978 Survey Drawing  
Same as March 1976
- Feb. Paul Schwimmer, PS # 24618  
1979 LCRC, Liber 5, Page 164  
Found 1/2" Iron Pipe  
6) Iron Pipe E'ly 33.0  
12) 18" Ash S85deg.E 33.0  
13) 16" Ash S80deg.E 32.0  
14) 8" Boxelder S80deg.W 33.9  
15) 12" Ash N70deg.W 28.2  
16) 6" Cherry N85deg.W 22.0
- Sept. Atwell-Hicks, Inc.  
1980 Surveying Drawing  
3/4" Iron Pipe  
5) 28" Walnut S25deg.E 77.7  
8) 18" Hickory S15deg.W 90.3  
12) 18" Ash East 33.7  
17) 14" Chinese Elm N30deg.E 40.83
- April Washtenaw Eng. Co., Inc.  
1987 Survey Drawing  
Found 3/4" Iron Pipe  
5) 32" Oak S25deg.E 78.13  
8) 18" Hickory S22deg.W 90.2  
12) 16" Boxelder S85deg.E 33.47  
15) 14" Boxelder N75deg.W 28.11
- May Midwestern Consulting Inc.  
1991 Survey Drawing  
Same as March 1976 and March 1978