

RFL

2000

SECTION

LAND CORNER RECORDATION CERTIFICATE
Filing Requirement of Act 74, Mich; P.A. 1970

For corner in
Washtenaw
(County)

Located in:

Corner Code #

1. Public Land Survey

T 2S R 7E

E-13

2. Property Controlling
in Section

S T R
S T R



5094769
Page: 1 of 2
02/07/2000 02:55P

Peggy M. Haines - Washtenaw Co. CORREM L-3 P-51

3. Miscellaneous
Property in Sec

S T R
S T R

Register of Deeds Stamp & File Number

4. Lot No. _____, Recorded Plat _____

5. Private Claims _____

I, Charles C. Wilson, in a field survey on September, 19 99, do hereby state that under requirements of P.A. 74, Michigan P.A. of 1970, the corner points mentioned in lines 1 and 2 above were in conformance with regulations and rules therefore as required in the current manual of survey instruction of the United States Department of the interior, Bureau of Land Management or by a decree of a Court of Law and/or that the corner points mentioned in lines 3, 4 and 5 above were in conformance with the rules of the Michigan Board of Land Surveyors or by a Decree of a Court of Law; established, re-established, monumented, recovered, found as expressed below.

	A	B	C	D	E	F	G	H	I	J	K	L	M
1													
2	6	5	4	3	2	1							
3													
4	7	8	9	10	11	12							
5													
6	18	17	16	15	14	13							
7													
8	19	20	21	22	23	24							
9													
10	30	29	28	27	26	25							
11													
12	31	32	33	34	35	36							
13													

NOTE: Not more than 2 corners, all in the same town and range, may be recorded on this certificate.

A. Description of original monument and accessories and/or subsequent restoration:

United States Government Survey, 1815 Instructions, Surveyed 1819, Joseph Wampler, D.S.
Bearing Trees A) W. Oak 30" N83deg.E 46.20
B) W. Oak 23" N64deg.W 39.60


Continued on Back

B. Description of corner evidence found and/or method applied in restoring or reestablishing corner:

Found 1/2" Iron Rod in a monument box in centerline of bituminous surface on Clark Road.

C. Description of monument for corner and accessories established to perpetuate locating the position of the corner:

Installed Remonumentation Cap on 1/2" Iron Rod in monument box
Previous Accessory 4) Utility Pole S40deg.E 68.73 Nail and RT N/S
Previous Accessory 8) SW Corner of Brick House N30deg.E 72.36
Previous Accessory 10) Top of Hydrant N60deg.E 52.2
Previous Accessory 11) 1/2" Iron Rod in monument box W'y 73.86 (Ypsilanti Twp. Corner)
New Accessory 16" Maple S30deg.E 45.39 Nail and RT NE/S
New Accessory Utility Pole S40deg.W 44.16 Nail and RT E/S
New Accessory Guy Pole N30deg.W 44.59 Nail and RT SW/S

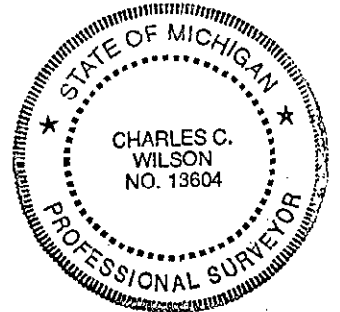

I find no evidence to conflict with the acceptance of this point as being the best available evidence for the position of this corner. This point was ratified by the Washtenaw County Peer Committee on November 15, 1999.

Signed by Charles C. Wilson
Surveyors Michigan's License No. 13604

Date November 15, 1999

APPROVED
DATE 11/15/99
CO. REP. KA

REF

2000

SECTION

Paragraph A Continued



5094769
Page: 2 of 2
02/07/2000 02:55P

Peggy M. Haines - Washtenaw Co. CORREM L-3 P-52

- May WCRC Grid Book, WJ Armstrong
1934 Found large rock, set 1-1/2" x 36" Iron Pipe, stones and bricks
1) 6" Aspen N67deg.E 25.0
2) 30" Maple NE 49.5
3) 8" Cherry S'ly 30.0
- March Midwestern Consulting
1976 Survey Drawing
Found Iron Pipe
4) Utility Pole S70deg.E 68.6
5) Utility Pole S30deg.E 44.8
6) SW Corner of house N15deg.E 77.2
- Feb. Paul Schwimmer, PS #24618
1979 LCRC, Liber 5, Page 164
Set 3/4" x 18" Iron Pipe from previous survey information
7) 36" Oak N70deg.W 70.4
8) SW Corner of house N30deg.E 72.4
9) 16" Boxelder N45deg.E 90.2
10) Top of hydrant N60deg.E 52.2
11) Ypsilanti Township Corner West 73.75
- May Midwestern Consulting
1991 Survey Drawing
Same as March 1976
- Oct. Washtenaw Eng. Co., Inc.
1991 Survey Drawing
1" Iron Pipe
12) 48" Oak N45deg.W 44.82
13) Corner of Stone House N45deg.E 89.68
14) Utility Pole South 34.50
15) Iron Pipe West 45.20