

SECTION

LAND CORNER RECORDATION CERTIFICATE
Filing Requirement of Act 74, Mich, P.A. 1970

For corner in Washtenaw Located in: _____ Corner Code # _____
(County)

- 1. Public Land Survey T 2S R 7E
- T _____ R _____
- T _____ R _____
- T _____ R _____
- 2. Property Controlling S _____ T _____ R _____
- in Section S _____ T _____ R _____
- 3. Miscellaneous S _____ T _____ R _____
- Property in Sec S _____ T _____ R _____



Page: 1 of 2
02/07/2000 02:55P
L-3 P-53

Peggy M. Haines - Washtenaw Co. CORREM

Register of Deeds Stamp & File Number

- 4. Lot No. _____, Recorded Plat _____
- 5. Private Claims _____

I, Charles C. Wilson, in a field survey on September, 19 99
do hereby state that under requirements of P.A. 74, Michigan P.A. of 1970, the corner points
mentioned in lines 1 and 2 above were in conformance with regulations and rules therefore as
required in the current manual of survey instruction of the United States Department of the
interior, Bureau of Land Management or by a decree of a Court of Law and/or that the corner
points mentioned in lines 3, 4 and 5 above were in conformance with the rules of the Michigan
Board of Land Surveyors or by a Decree of a Court of Law, established, re-established,
monumented, recovered, found as expressed below.

NOTE: Not more than 2 corners, all in the same town and range, may be recorded
on this certificate.

	A	B	C	D	E	F	G	H	I	J	K	L	M
1													
2	6		5		4		3		2		1		
3													
4	7		8		9		10		11		12		
5													
6	18		17		16		15		14		13		
7													
8	19		20		21		22		23		24		
9													
10	30		29		28		27		26		25		
11													
12	31		32		33		34		35		36		
13													

A. Description of original monument and accessories and/or subsequent restoration:

United States Government Survey, 1815 Instructions, Surveyed 1819, Joseph Wampler, D.S.
Bearing Trees A) W. Oak 5" N14deg.E 7.26
B) B. Oak 4" S28deg.W 1.98


Continued on Back

B. Description of corner evidence found and/or method applied in restoring or reestablishing corner:

Found 1/2" Iron Rod in centerline of gravel surface on Vreeland Road, 0.3 below gravel surface.

C. Description of monument for corner and accessories established to perpetuate locating the position of the corner:

Installed Remonumentation Cap over existing 1/2" Iron Rod and lowered it to 0.6 below gravel surface
Previous Accessory 3) 30" Oak N50deg.W 58.43 Nail and RT S/S
Previous Accessory 4) 12" Walnut N10deg.E 28.88 Nail and RT E/S
Previous Accessory 5) 14" Elm S40deg.E 28.84 Nail and RT N/S
Previous Accessory 6) Utility Pole S65deg.W 61.66 Nail and RT S/S
Previous Accessory 7) 8" Elm S15deg.W 25.24 Nail and RT E/S

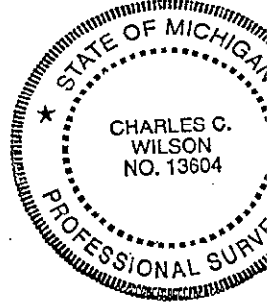

I find no evidence to conflict with the acceptance of this point as being the best available evidence for the position of this corner.
This point was ratified by the Washtenaw County Peer Committee on November 15, 1999.

Signed by Charles C. Wilson
Surveyors Michigan's License No. 13604

Date November 15, 1999

APPROVED
DATE 11/15/99
CO. REP. [Signature]

REK

2000

SECTION

Copy



5094770
Page: 2 of 2
02/07/2000 02:55P

Paragraph A Continued

Peggy M. Haines - Washtenaw Co. CORREM L-3 P-54

1870+- Pettibone's Witness Book on file at Atwell-Hicks, Inc.

- 1) 18" Maple S15deg.E 25.74
- 2) 20" W. Oak S44-1/2deg.W 42.90

Dec. Atwell-Hicks, Inc.

1985 Survey Drawing

Found 1/4" Bar

- 3) 30" Oak N50deg.W 58.3
- 4) 6" Walnut North 29.0
- 5) 6" Chinese Elm S45deg.E 29.1
- 6) Utility Poie S45deg.W 61.5

Aug. C. Wilson & Associates, Inc.

1991 Survey Drawing

Found 1/2" Rod

- 3) 40" Oak N65deg.W 58.41
- 4) 10" Walnut N10deg.E 28.84
- 5) 12" Elm S40deg.E 29.03
- 6) Utility Pole S65deg.W 61.68
- 7) 6" Elm S25deg.W 25.25

Feb. WCRC Grid Book

1994 3) 30" Oak N40deg.W 58.44

- 4) 6" Elm North 28.84
- 6) Utility Pole S50deg.W 61.72
- 7) 6" Elm S15deg.W 25.26