

REF

2000

SECTION

LAND CORNER RECORDATION CERTIFICATE
Filing Requirement of Act 74, Mich, P.A. 1970

For corner in Washtenaw
(County)

Located in:

Corner Code #

- 1. Public Land Survey T 2S R 7E
T _____ R _____
T _____ R _____
T _____ R _____
- 2. Property Controlling S _____ T _____ R _____
in Section S _____ T _____ R _____
- 3. Miscellaneous S _____ T _____ R _____
Property in Sec S _____ T _____ R _____

F-11

Copy



5094771
Page: 1 of 2
02/07/2000 02:55P
L-3 P-55

Peggy M. Haines - Washtenaw Co. CORREM

Register of Deeds Stamp & File Number

- 4. Lot No. _____, Recorded Plat _____
- 5. Private Claims _____

I, Charles C. Wilson, in a field survey on September, 19 99
do hereby state that under requirements of P.A. 74, Michigan P.A. of 1970, the corner points
mentioned in lines 1 and 2 above were in conformance with regulations and rules therefore as
required in the current manual of survey instruction of the United States Department of the
interior, Bureau of Land Management or by a decree of a Court of Law and/or that the corner
points mentioned in lines 3, 4 and 5 above were in conformance with the rules of the Michigan
Board of Land Surveyors or by a Decree of a Court of Law, established, re-established,
monumented, recovered, found as expressed below.

NOTE: Not more than 2 corners, all in the same town and range, may be recorded
on this certificate.

	A	B	C	D	E	F	G	H	I	J	K	L	M
1													
2	8		5		4		3		2		1		
3													
4	7		8		9		10		11		12		
5													
6	18		17		16		15		14		13		
7													
8	19		20		21		22		23		24		
9													
10	30		29		28		27		26		25		
11													
12	31		32		33		34		35		36		
13													

A. Description of original monument and accessories and/or subsequent restoration:

United States Government Survey, 1815 Instructions, Surveyed 1819, Joseph Wampler, D.S.
Bearing Trees A) Ash 9" S24deg.E 1.98
B) Elm 44" N9deg.E 11.55


Continued on Back

B. Description of corner evidence found and/or method applied in restoring or reestablishing corner:

Found 1/2" Iron Pipe 2 feet South of centerline of bituminous surface on Geddes Road, 0.4 below bituminous surface.

C. Description of monument for corner and accessories established to perpetuate locating the position of the corner:

Installed Remonumentation Cap over existing 1/2" Iron Pipe, 0.4 below bituminous surface.
Previous Accessory 4) 3/4" Iron Pipe S'y 32.90
Previous Accessory 10) MBT Riser Box S76deg.E 119.7
Previous Accessory 12) Speed Limit Sign S56deg.W 29.59
New Accessory Utility Pole N35deg.E 39.87 Nail and RT SE/S
New Accessory Do Not Pass Sign S80deg.E 112.48

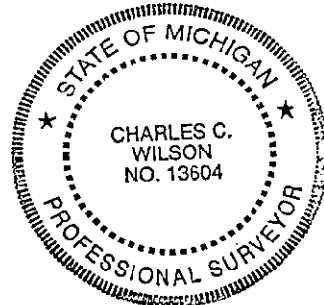

I find no evidence to conflict with the acceptance of this point as being the best available evidence for the position of this corner.
This point was ratified by the Washtenaw County Peer Committee on November 15, 1999.
Washtenaw County Road Commission will install monument box at a later date.

Signed by Charles C. Wilson
Surveyors Michigan's License No. 13604

Date November 15, 1999


APPROVED
DATE 11/15/99
CO. REP. [Signature]

REF

2000

SECTION

- Copy -



5094771
 Page: 2 of 2
 02/07/2000 02:55P
 Peggy M. Haines - Washtenaw Co. CORREM L-3 P-56

Paragraph A Continued

1870+- Pettibone's Witness Book on file at Atwell-Hicks Inc.

- 1) 34" BO S8-1/2deg.E 38.94
- 2) 24" WO S59deg.E 45.54

May WCRC Grid Book, WJ Armstrong

1934 Found large stone on end with small stones around it. Set Iron Pipe, stones and bricks

- No Witness Trees
- 3) Iron Pipe North 33.0
- 4) Iron Pipe South 33.0

Oct. Atwell-Hicks Survey Drawing

1973 Found 3/4" Iron Pipe

- 4) Iron Pipe South 33.0
- 5) Center of road South 2.0
- 6) Range of fence S'ly East 3.0

May Atwell-Hicks Inc.

1975 Survey Drawing
Same as October 1973

Oct. Atwell-Hicks Inc.

1981 Survey Drawing
Same as October 1973 and May 1975

Aug. C. Wilson & Associates, Inc.

1991 Survey Drawing
Found 1/2" Iron Pipe

- 7) Utility Pole N80deg.W 153.00
- 8) Utility Pole N30-1/2deg.E 39.25
- 9) Utility Pole N78deg.E 200.34
- 10) MBT Riser Box S76deg.E 119.7
- 11) 16" Poplar S'ly 138.91

Mar. WCRC

1994 Book F-10, Page 8
Found 3/4" Iron Pipe

- 4) IronPipe S4deg.W 32.90
- 8) Utility Pole N38deg.E 38.38
- 12) Speed Limit Sign S56deg.W 29.71
- 13) Speed Limit Sign N17deg.W 22.05