

SECTION

LAND CORNER RECORDATION CERTIFICATE
Filing Requirement of Act 74, Mich; P.A. 1970

For corner in Washtenaw
(County)

Located in:

Corner Code #

1. Public Land Survey

T 2S R 7E

F-13

Copy

2. Property Controlling
in Section

S T R

3. Miscellaneous
Property in Sec

S T R

S T R



5094772
Page: 1 of 2
02/07/2000 02:55P

Register of Deeds Stamp & File Number

4. Lot No. , Recorded Plat
5. Private Claims

I, Charles C. Wilson, in a field survey on November , 19 99^{*}
do hereby state that under requirements of P.A. 74, Michigan P.A. of 1970, the corner points
mentioned in lines 1 and 2 above were in conformance with regulations and rules therefore as
required in the current manual of survey instruction of the United States Department of the
interior, Bureau of Land Management or by a decree of a Court of Law and/or that the corner
points mentioned in lines 3, 4 and 5 above were in conformance with the rules of the Michigan
Board of Land Surveyors or by a Decree of a Court of Law, established, re-established,
monumented, recovered, found as expressed below.

	A	B	C	D	E	F	G	H	I	J	K	L	M
1													
2	6		5		4		3		2		1		
3													
4	7		8		9		10		11		12		
5													
6	18		17		16		15		14		13		
7													
8	19		20		21		22		23		24		
9													
10	30		29		28		27		26		25		
11													
12	31		32		33		34		35		36		
13													

NOTE: Not more than 2 corners, all in the same town and range, may be recorded on this certificate.

A. Description of original monument and accessories and/or subsequent restoration:

United States Government Survey, 1815 Instructions, Surveyed 1819, Joseph Wampler, D.S.
Bearing Trees A) Aspen S60-3/4deg.W 44.88


Continued on Back

B. Description of corner evidence found and/or method applied in restoring or reestablishing corner:

Did not find corner, all previous accessories are gone. Reset corner with 3/4" Iron Pipe with a Remonumentation Cap in a monument box according to monumentation found on a previous survey by Atwell-Hicks, Inc., dated, 1955.

C. Description of monument for corner and accessories established to perpetuate locating the position of the corner:

3/4" Iron Pipe with Remonumentation Cap in monument box
Top of Hydrant S5deg.W 31.35
3/4" IronPipe N^{ly} 33.00
North end 60" CMP N60deg.E 33.80
Utility Pole N65deg.W 85.35 Nail and RT E/S
Utility Pole N30deg.W 50.40 Nail and RT W/S
Utility Pole S85deg.W 135.07 Nail and RT N/S
3/4" Iron Pipe W^{ly} 12.28 (believed previously used erroneously as the location for F13)

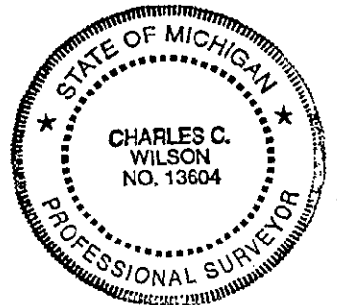

I find no evidence to conflict with the acceptance of this point as being the best available evidence for the position of this corner. This point was ratified by the Washtenaw County Peer Committee on December 6, 1999.

Signed by Charles C. Wilson
Surveyors Michigan's License No. 13604

Date December 8, 1999

APPROVED
DATE 11/15/99
CO. REP. KA

RFI

ST. 10/1/00

2000

SECTION

Copy -



5094772
Page: 2 of 2
02/07/2000 02:55P

Peggy M. Haines - Washtenaw Co. CORREM L-3 P-58

Paragraph A Continued

1900+- WCRC Book 147, Page 57, CS Woodard
1) SW Oak 24" SW 141.9
2) Ypsilanti Township Corner West 118.14

May WCRC Grid Book and Book 147, Page 57 & 58, WJ Armstrong
1938 Found 3 old wood stakes. Set 1-1/2" Iron Pipe, stones and bricks
2) Ypsilanti Township Corner West 120.2
3) 36" Willow N72deg.E 61.7
4) 36" Willow N77deg.E 91.4
5) NW Corner of Bridge Floor S83deg.E 18.7
6) SW Corner of Bridge Floor S41deg.E 25.2
7) 7" Forked Boxelder S28deg.W 60.8
8) 4" Twin Cherry S42deg.W 57.3
9) 4" Twin SW Oak S51deg.W 62.0
10) 5" Boxelder N4deg.E 24.2

Nov. WCRC Grid Book
1974 11) Utility Pole N37deg.E 49.98
12) Top of Hydrant S7deg.E 31.38
13) Utility Pole S52deg.E 50.22
14) Iron Pipe S'y 32.34
15) Iron Pipe N'y 33.07
16) Chiseled "X" in top end of 60" CMP N50deg.E 44.48

Nov. Land Surveying Consultants
1990 Survey Drawing
Found 3/4" Iron Rod
17) Utility Pole S45deg.E 59.91
18) Utility Pole N55deg.W 75.28
19) Utility Pole N15deg.W 45.41
20) Utility Pole S75deg.W 123.47

Oct. Washtenaw Eng. Co., Inc.
1991 Survey Drawing
1-1/2" Iron Pipe
12) Top of hydrant S15deg.E 30.95
17) Utility Pole S60deg.E 59.90
18) Utility Pole N55deg.W 75.25
19) Utility Pole N20deg.W 45.39

