

SECTION

LAND CORNER RECORDATION CERTIFICATE
Filing Requirement of Act 74, Mich; P.A. 1970

For corner in

Washtenaw
(County)

Located in:

Corner Code #

1. Public Land Survey

T 2S R 7E
T
T
T
S T R
S T R
S T R

G-9



5094773
Page: 1 of 2
02/07/2000 02:56P
L-3 P-59

Register of Deeds Stamp & File Number

4. Lot No.
5. Private Claims

I, Charles C. Wilson, in a field survey on September, 19 99, do hereby state that under requirements of P.A. 74, Michigan P.A. of 1970, the corner points mentioned in lines 1 and 2 above were in conformance with regulations and rules therefore as required in the current manual of survey instruction of the United States Department of the interior, Bureau of Land Management or by a decree of a Court of Law and/or that the corner points mentioned in lines 3, 4 and 5 above were in conformance with the rules of the Michigan Board of Land Surveyors or by a Decree of a Court of Law, established, re-established, monumented, recovered, found as expressed below.

Grid table with columns A-M and rows 1-13. Cell (9, H) contains a small circle symbol.

NOTE: Not more than 2 corners, all in the same town and range, may be recorded on this certificate.

A. Description of original monument and accessories and/or subsequent restoration:

United States Government Survey, 1815 Instructions, Surveyed 1819, Joseph Wampler, D.S.
Bearing Trees A) Tam 5" N76-1/2deg.W 68.64
B) Tam 6" S72deg.E 66.0


Continued on Back

B. Description of corner evidence found and/or method applied in restoring or reestablishing corner:

Found 3/4" Iron Pipe at bituminous surface in centerline of Prospect Road and 24 feet South of centerline of Vreeland Road.

C. Description of monument for corner and accessories established to perpetuate locating the position of the corner:

Installed Remonumentation Cap on existing 3/4" Iron Pipe
Previous Accessory 5) Utility Pole N32deg.W 58.13 Nail and RT SW/S
Previous Accessory 7) Guy Pole N80deg.E 46.87 Nail and RT S/S
Previous Accessory 9) Top of Guard Rail Post N50deg.E 23.85 Nail and RT
Previous Accessory 10) Top of Guart Rail Post S60deg.E 19.34 Nail and RT
Previous Accessory 11) Edge of bituminous pavement E'ly 12.0
New Accessory Top of Guard Rail Post S60deg.W 20.58 Nail and RT

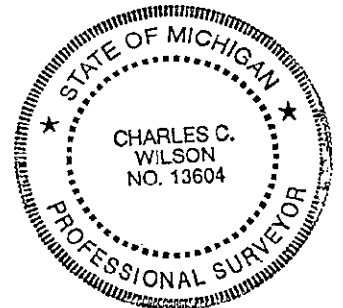

I find no evidence to conflict with the acceptance of this point as being the best available evidence for the position of this corner. This point was ratified by the Washtenaw County Peer Committee on November 15, 1999. Washtenaw County Road Commission will install monument box at a later date.

Signed by [Signature]
Surveyors Michigan's License No. 13604

Date November 15, 1999

APPROVED
DATE 11/15/99
CO. REP. [Signature]

REF

SLIP

2000

SECTION

Paragraph A Continued

- 1930+- WCRC Grid Book, HH Atwell
Chisel hole with lead
- 1) 20" Twin Elm S30deg.W 40.15
 - 2) 14" Elm S70deg.W 25.6
 - 3) 4" Elm N85deg.E 76.0
 - 4) 12" Elm N50deg.E 29.4
- 1969 WCRC Grid Book
- 3) 22" Elm N83deg.E 75.69
 - 5) Utility Pole N32deg.W 58.58
 - 6) Utility Pole N38deg.E 51.55
 - 7) Guy Pole N76deg.E 46.91
- Jan. Robert Campbell, PS #13028
- 1985 LCRC, Liber 7, Page 46
Found 3/4" Iron Pipe in Monument Box. Removed Iron Pipe and Monument Box.
Set 3/4" x 18" Iron Pipe
- 5) Utility Pole N31deg.W 58.46
 - 7) Guy Pole N80deg.E 46.9
 - 8) Centerline of Vreeland Road Nly 24'
 - 9) Guard Post N50deg.E 23.97
 - 10) Guard Post S59deg.E 19.39
 - 11) Edge of pavement East 12.0
- Dec. Atwell Hicks Inc.
- 1985 Survey Drawing
Found 3/4" Iron Pipe
- 8) Centerline of traveled Vreeland Road Wly, Nly 24.0'
 - 9) Top of guard rail post N50deg.E 23.97
 - 10) Top of guard rail post S59deg.E 19.39



5094773

Page: 2 of 2

02/07/2000 02:55P

Peggy M. Haines - Washtenaw Co. CORREM

L-3 P-60