

SECTION

LAND CORNER RECORDATION CERTIFICATE  
Filing Requirement of Act 74, Mich; P.A. 1970

For corner in

Washtenaw  
(County)

Located in:

Corner Code #

1. Public Land Survey

T 2S R 7E

G-10

T \_\_\_\_\_ R \_\_\_\_\_

T \_\_\_\_\_ R \_\_\_\_\_

T \_\_\_\_\_ R \_\_\_\_\_

2. Property Controlling  
in Section

S \_\_\_\_\_ T \_\_\_\_\_ R \_\_\_\_\_

S \_\_\_\_\_ T \_\_\_\_\_ R \_\_\_\_\_

3. Miscellaneous

S \_\_\_\_\_ T \_\_\_\_\_ R \_\_\_\_\_

Property in Sec

S \_\_\_\_\_ T \_\_\_\_\_ R \_\_\_\_\_

*- Copy -*



5094774  
Page: 1 of 2  
02/07/2000 02:55P  
L-3 P-61  
Peggy M. Haines - Washtenaw Co. CORREM

Register of Deeds Stamp & File Number

4. Lot No. \_\_\_\_\_, Recorded Plat \_\_\_\_\_

5. Private Claims \_\_\_\_\_

I, Charles C. Wilson, in a field survey on September, 19 99  
do hereby state that under requirements of P.A. 74, Michigan P.A. of 1970, the corner points  
mentioned in lines 1 and 2 above were in conformance with regulations and rules therefore as  
required in the current manual of survey instruction of the United States Department of the  
interior, Bureau of Land Management or by a decree of a Court of Law and/or that the corner  
points mentioned in lines 3, 4 and 5 above were in conformance with the rules of the Michigan  
Board of Land Surveyors or by a Decree of a Court of Law, established, re-established,  
monumented, recovered, found as expressed below.

	A	B	C	D	E	F	G	H	I	J	K	L	M
1													
2	6	5	4	3	2	1							
3													
4	7	8	9	10	11	12							
5													
6	18	17	16	15	14	13							
7													
8	19	20	21	22	23	24							
9													
10	30	29	28	27	26	25							
11													
12	31	32	33	34	35	36							
13													

NOTE: Not more than 2 corners, all in the same town and range, may be recorded on this certificate.

A. Description of original monument and accessories and/or subsequent restoration:

United States Government Survey, 1815 Instructions, Surveyed 1819, Joseph Wampler, D.S.  
Bearing Trees A) Ash 9" S35-1/2deg.E 17.82  
B) W. Oak 56" N55deg.W 7.26


Continued on Back

B. Description of corner evidence found and/or method applied in restoring or reestablishing corner:

Found 3/4" Iron Pipe in centerline of bituminous surface on Prospect Road

C. Description of monument for corner and accessories established to perpetuate locating the position of the corner:

Installed Remonumentation Cap on existing 3/4" Iron Pipe at bituminous surface  
Previous Accessory 7) 15" Juniper S50deg.E 67.07 Nail and RT N/S  
Previous Accessory 14) 15" Twin Locust S30deg.W 68.80 Nail and RT E/S  
Previous Accessory 16) Edge of bituminous pavement West 12.5  
Previous Accessory 17) Edge of bituminous pavement East 11.8  
New Accessory 8" Walnut S80deg.E 65.06 Nail and RT N/S  
New Accessory 8" Multiple Elm S35deg.W 51.32 Nail and RT E/S  
New Accessory 12" Poplar N45deg.E 45.12 Nail and RT NW/S  
New Accessory 10" Poplar N60deg.E 53.73 Nail and RT S/S  
I find no evidence to conflict with the acceptance of this point as being the best available evidence for the position of this corner.  
This point was ratified by the Washtenaw County Peer Committee on November 15, 1999.  
Washtenaw County Road Commission will install monument box at a later date.

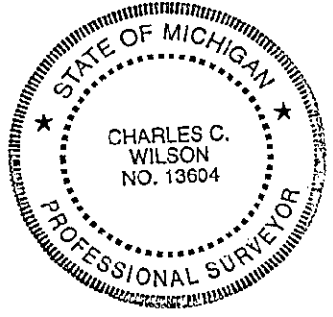


Signed by Charles C. Wilson  
Surveyors Michigan's License No. 13604

Date November 15, 1999

APPROVED  
DATE 11/15/99  
CO. REP. KX

## SECTION

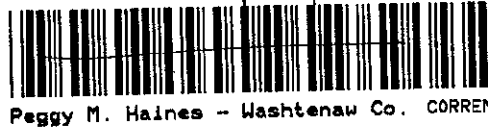

5094774  
 Page: 2 of 2  
 02/07/2000 02:55P  
 L-3 P-62

## Paragraph A Continued

1870+- Pettibones' Witness Book on file at Atwell-Hicks Inc.

- 1) 22" Sugar S66-1/2deg.W 40.92
- 2) 14" Basswood N69deg.W 74.58

Dec. WCRC Grid Book, WJ Armstrong

1933 Found old wood stake with 3/4" Iron Pipe driven into it and surrounded by stones.

Set 1" x 28" Iron Pipe on top with 4 bricks around it.

- 3) 14" Elm N27-1/2deg.W 56.4
- 4) 18" Elm N19deg.W 81.6
- 5) 28" Elm N19deg.E 95.3
- 6) 40" Elm N27-1/2deg.E 51.4
- 7) 8" Juniper S52deg.E 67.0
- 8) 12" Hickory S13deg.E 103.7
- 9) Iron Pipe E'ly 33.0
- 10) Iron Pipe W'ly 33.0

Oct. Atwell-Hicks Inc.

1973 Survey Drawing

Found 1" Iron Pipe in Monument Box

- 10) Iron Pipe W'ly 33.0
- 11) 12" Juniper S52deg.E 42.5
- 12) 12" Twin Locust S15deg.W 17.0

May Atwell-Hicks Inc.

1975 Survey Drawing

Same as October 1973

Oct. Atwell-Hicks Inc.

1981 Survey Drawing

Same as October 1973 and May 1975

Jan. Robert Campbell, PS #13028

1985 LCRC, Liber 7, Page 47

Found 1" Iron Pipe in Monument Box

Removed Iron Pipe and Monument Box.

Set 3/4" x 18" Iron Pipe

- 13) 8" Poplar N61deg.E 63.55
- 14) 17" Twin Locust S28deg.W 68.88
- 15) 8" Elm N80deg.W 30.31
- 16) Edge of pavement West 12.5
- 17) Edge of pavement East 11.8

Mar. WCRC, Book F-10, Page

1994 Found 3/4" Iron Pipe

- 7) 15" Juniper S49deg.E 67.00
- 10) Iron Pipe W'ly 33.08
- 14) 15" Twin Locust S26deg.W 68.80
- 15) 9" Elm N77deg.W 30.33
- 16) Edge of Pavement West 12.5
- 17) Edge of Pavement East 11.8

18) Utility Pole N36deg.E 57.28

19) Twin Oak S51deg.W 46.13