

REF

2000

LAND CORNER RECORDATION CERTIFICATE

Filing Requirement of Act 74, Mich, P.A. 1970

For corner in Washtenaw (County) Located in: Corner Code #

- 1. Public Land Survey T 2S R 7E G-11
2. Property Controlling in Section S T R
3. Miscellaneous Property in Sec S T R
4. Lot No. Recorded Plat
5. Private Claims



5094775 Page: 1 of 2 02/07/2000 02:55P

Register of Deeds Stamp & File Number

I, Charles C. Wilson, in a field survey on September, 19 99 do hereby state that under requirements of P.A. 74, Michigan P.A. of 1970, the corner points mentioned in lines 1 and 2 above were in conformance with regulations and rules therefore as required in the current manual of survey instruction of the United States Department of the interior, Bureau of Land Management or by a decree of a Court of Law and/or that the corner points mentioned in lines 3, 4 and 5 above were in conformance with the rules of the Michigan Board of Land Surveyors or by a Decree of a Court of Law, established, re-established, monumented, recovered, found as expressed below.

NOTE: Not more than 2 corners, all in the same town and range, may be recorded on this certificate.

Grid table with columns A-M and rows 1-13. A dot is marked at the intersection of column H and row 11.

A. Description of original monument and accessories and/or subsequent restoration:

United States Government Survey, 1815 Instructions, Surveyed 1819, Joseph Wampler, D.S.


Continued on Back

B. Description of corner evidence found and/or method applied in restoring or reestablishing corner:

Found 3/4" Iron Pipe with nail and Washtenaw County Road Commission washer in monument box at centerline intersection of Geddes and Prospect Roads.

C. Description of monument for corner and accessories established to perpetuate locating the position of the corner:

- 3/4" Iron Pipe with nail and Washtenaw County Road Commission washer in monument box
Previous Accessory 19) 20" Hickory N20deg.W 86.06 Nail and RT E/S
Previous Accessory 22) Top of Hydrant S60deg.E 103.64
Previous Accessory 23) SW Corner of MBT Junction Box S35deg.E 105.93
New Accessory Utility Pole N60deg.E 52.78 Nail and RT S/S
New Accessory Guy Pole S55deg.W 55.02 Nail and RT SE/S

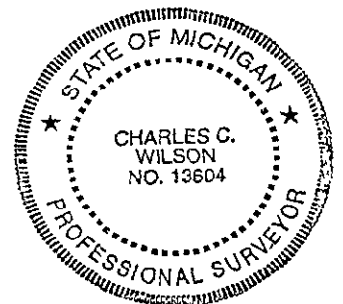

I find no evidence to conflict with the acceptance of this point as being the best available evidence for the position of this corner. This point was ratified by the Washtenaw County Peer Committee on November 15, 1999.

Signed by [Signature] Surveyors Michigan's License No. 13604

Date November 15, 1999

APPROVED DATE 11/15/99 CO. REP. [Signature]

## SECTION

## Paragraph A Continued



5094775  
Page: 2 of 2  
02/07/2000 02:55P

Peggy M. Haines - Washtenaw Co. CORREM L-3 P-64

- 1870+- Pettibone's Witness Book on file at Atwell-Hicks, Inc.  
 1) 12" Basswood N9-1/2deg.W 28.38  
 2) 8" Butternut S51-3/4deg.E 50.82  
 3) 10" Hickory N55-1/2deg.E 56.76
- April HH Atwell, Book 551, Page 77  
 1924 WCRC Grid Book  
 4) 24" Elm N66deg.W 72.3  
 5) 12" Hickory N27deg.W 76.0  
 6) 24" Elm S16deg.E 108.4  
 7) 40" Oak S63deg.E 82.2  
 8) 20" Hickory S14-3/4deg.W 126.6  
 9) 24" Hickory N44-1/2deg.W 50.5  
 10) 18" Hickory N26deg.E 82.4  
 11) 10" W. Oak N52-1/2deg.E 32.4  
 12) 6" Butternut S61deg.E 45.5  
 13) 8" Butternut N65-1/2deg.E 59.8  
 14) 10" Forked Butternut N69deg.E 67.8  
 15) 3" Maple S34deg.E 54.8  
 16) 24" Hickory S43deg.W 30.5
- 1968 WCRC Grid Book  
 1" Iron Pipe  
 17) Utility Pole S16deg.E 102.63  
 18) Guy Pole S45deg.W 46.47  
 19) 15" Hickory N20deg.W 86.10  
 20) Utility Pole N57deg.E 38.25
- Oct. Atwell-Hicks Inc.  
 1973 Survey Drawing  
 Found 1" Iron Pipe in Monument Box  
 8) 36" Hickory S14deg.W 126.6  
 19) 15" Hickory N27deg.W 86.0
- May Atwell-Hicks Inc.  
 1975 Survey Drawing  
 Same as October 1973
- Oct. Atwell-Hicks Inc.  
 1981 Survey Drawing  
 Same as October 1973 and may 1975
- Jan. Robert Campbell, PS #13208  
 1985 LCRC, Liber 7, Page 48  
 Found 1" Iron Pipe in Monument Box  
 Removed Iron Pipe and Monument Box and found 1-1/2" Iron Pipe below  
 Set 3/4" x 6" Iron Pipe over 1-1/2" Iron Pipe  
 5) 13" Stump N25deg.W 76.0  
 19) 17" Hickory N18deg.W 85.9  
 20) Utility Pole N59deg.E 38.10  
 21) Center of Geddes Road North 4.5  
 22) Top Nut Fire Hydrant S61deg.E 103.7  
 23) MBT Box S35deg.E 95.43  
 24) Signal Light Pole S55deg.W 46.25
- Mar. WCRC, Book F-10, Page 9  
 1994 Found 3/4" Iron Pipe  
 19) 17" Hickory N18deg.W 85.84'  
 20) Utility Pole N59deg.E 38.29  
 21) Center of Geddes Road North 4.5  
 22) Top Nut Fire Hydrant S61deg.E 103.65  
 23) MBT Box S35deg.E 95.27  
 25) Guy Pole S47deg.W 46.52