

SECTION

LAND CORNER RECORDATION CERTIFICATE
Filing Requirement of Act 74, Mich. P.A. 1970

For corner in Washtenaw
(County)

Located in:

Corner Code #

1. Public Land Survey

T 2S R 7E

G-12

2. Property Controlling
in Section

S _____ T _____ R _____
S _____ T _____ R _____

3. Miscellaneous
Property in Sec

S _____ T _____ R _____
S _____ T _____ R _____

4. Lot No. _____, Recorded Plat _____

5. Private Claims _____



5094776
Page: 1 of 2
02/07/2000 02:55P
L-3 P-65

Register of Deeds Stamp & File Number

	A	B	C	D	E	F	G	H	I	J	K	L	M
1													
2	8		5		4		3		2		1		
3													
4	7		8		9		10		11		12		
5													
6	18		17		16		15		14		13		
7													
8	19		20		21		22		23		24		
9													
10	30		29		28		27		26		25		
11													
12	31		32		33		34		35		36		
13													

I, Charles C. Wilson, in a field survey on September, 19 99, do hereby state that under requirements of P.A. 74, Michigan P.A. of 1970, the corner points mentioned in lines 1 and 2 above were in conformance with regulations and rules therefore as required in the current manual of survey instruction of the United States Department of the interior, Bureau of Land Management or by a decree of a Court of Law and/or that the corner points mentioned in lines 3, 4 and 5 above were in conformance with the rules of the Michigan Board of Land Surveyors or by a Decree of a Court of Law, established, re-established, monumented, recovered, found as expressed below.

NOTE: Not more than 2 corners, all in the same town and range, may be recorded on this certificate.

A. Description of original monument and accessories and/or subsequent restoration:

United States Government Survey, 1815 Instructions, Surveyed 1819, Joseph Wampler, D.S.
Bearing Trees A) W. Oak 60" N86deg.W 7.59
B) W. Oak 33" S7deg.W 25.74


Continued on Back

B. Description of corner evidence found and/or method applied in restoring or reestablishing corner:

Found 3/4" Iron Pipe in centerline of bituminous surface on Prospect Road.

C. Description of monument for corner and accessories established to perpetuate locating the position of the corner:

Installed Remonumentation Cap on existing 3/4" Iron Pipe at bituminous surface
Previous Accessory 1) 55" Boxelder N45deg.W 66.80 Nail and RT NE/S
Previous Accessory 6) 48" Oak S20deg.E 108.02 Nail and RT W/S
Previous Accessory 7) 33" Hickory S15deg.W 124.31 Nail and RT E/S
Previous Accessory 20) NE Corner of Brick House S50deg.W 128.56
New Accessory SE Corner of Brick House S70deg.W 157.36
New Accessory 12" Poplar N75deg.E 34.71 Nail and RT N/S

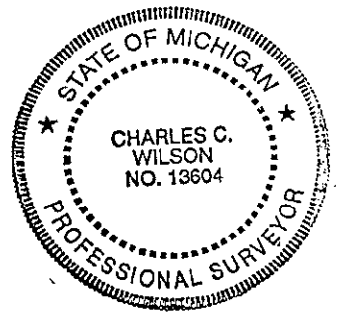

I find no evidence to conflict with the acceptance of this point as being the best available evidence for the position of this corner. This point was ratified by the Washtenaw County Peer Committee on November 15, 1999. Washtenaw County Road Commission will install monument box at a later date

Signed by Charles C. Wilson
Surveyors Michigan's License No. 13604

Date November 15, 1999

APPROVED
DATE 11/15/99
CO. REP. [Signature]

REF

2000

SECTION



5094776
Page: 2 of 2
02/07/2000 02:55P

Peggy M. Haines - Washtenaw Co. CORREM L-3 P-66

Paragraph A Continued

- 1870+- Pettibone's Witness Book on file at Atwell-Hicks Inc.
 - 1) 3" Plum N41deg.W 67.98
 - 2) 5" Hickory S32deg.E 62.04
 - 3) 6" Hickory S87-1/4deg.W 101.64

- 1900+- CS Woodard
 - 3) 6" Hickory S85deg.W 100.32
 - 4) 10" B. Oak S21deg.E 85.80

- June WCRC Grid Book and Book 147, Page 92, WJ Armstrong
 - 1939 Found sleigh shoe and traces of witnesses 2) and 3)
 - Set short iron on top and bricks
 - 5) 16" Elm N27deg.E 77.7
 - 6) 26" W. Oak S16deg.E 109.1
 - 7) 26" Hickory S14deg.W 124.7
 - 8) 8" Cherry S27-1/2deg.W 70.9
 - 9) 8" Cherry S30deg.W 64.3
 - 10) SE Corner of House N48-1/2deg.W 97.2

- Aug. WCRC Grid Book
 - 1968 1' Iron Pipe
 - 1) 36" Boxelder N40deg.W 67.71
 - 11) Utility Pole N34deg.W 42.55
 - 12) 18" Boxelder N31deg.W 83.40
 - 13) Utility Pole N22deg.E 96.03
 - 14) Utility Pole S19deg.E 81.93

- Oct. Atwell-Hicks Inc.
 - 1973 Survey Drawing
 - Found 1" Iron Pipe in Monument Box
 - 7) 30" Hickory S14deg.W 124.7
 - 10) SE Corner of House 97.2
 - 15) 36" W. Oak S16deg.E 104.1

- Nov. WCRC Grid Book
 - 1974 1) 36" Boxelder N40deg.W 67.65
 - 6) 40" W. Oak S16deg.E 108.95
 - 7) 29" Hickory S14deg.W 124.40
 - 11) Utility Pole N34deg.W 42.22
 - 12) 18" Boxelder (DEAD) N31deg.W 83.39
 - 16) Utility Pole E'y 57.78
 - 17) Iron Pipe W'y 32.99

- Feb. Allen Rentschler, PS #15411
 - 1983 LCRC, Liber 6, Page 268
 - Found Iron Pipe
 - 15) Utility Pole S85deg.E 57.83
 - 18) 24" Boxelder N30deg.W 87.75
 - 19) 36" Boxelder N19deg.W 67.40

- Jan. Robert Campbell, PS #13028
 - 1985 LCRC, Liber 7, Page 49
 - Found 1" Iron Pipe in Monument Box
 - Removed Iron Pipe and Monument Box and found 1" Iron Pipe below
 - Set 3/4" x 18" Iron Pipe over last 1" Iron Pipe
 - 1) 42" Boxelder N40deg.W 67.35
 - 6) 43" Oak S14deg.E 109.1
 - 7) 31" Hickory S20deg.W 124.31
 - 15) Utility Pole S80deg.E 57.77
 - 20) NE Corner of House S75deg.W 128.7
 - 21) Edge of pavement East 12.2

- Nov. Land Surveying Consultants
 - 1990 Survey Drawing
 - Found 3/4" Iron Pipe
 - 5) 16" Elm N27deg.E 77.78
 - 8) 8" Cherry S27deg.W 70.90
 - 9) 8" Cherry S30deg.W 64.32
 - 10) SE Corner of House N48deg.W 97.22

- Mar. WCRC, Book F-10, Page 7
 - 1994 Found 3/4" Iron Pipe
 - 1) 48" Boxelder N40deg.W 67.30
 - 6) 40" Oak S14deg.E 108.56
 - 7) 32" Hickory S14deg.W 124.41
 - 15) Utility Pole Easterly 57.78
 - 22) Iron Pipe W'y 33.00