

REF

2000

SECTION

LAND CORNER RECORDATION CERTIFICATE
Filing Requirement of Act 74, Mich, P.A. 1970

For corner in
Washtenaw
(County)

Located in:

Corner Code #

- 1. Public Land Survey
- 2. Property Controlling in Section
- 3. Miscellaneous Property in Sec

T 2S R 7E
 T _____ R _____
 T _____ R _____
 T _____ R _____
 S _____ T _____ R _____
 S _____ T _____ R _____
 S _____ T _____ R _____

H-9



5094778
Page: 1 of 2
02/07/2000 02:55P

Register of Deeds Stamp & File Number

- 4. Lot No. _____, Recorded Plat _____
- 5. Private Claims _____

I, Charles C. Wilson, in a field survey on September, 19 99
do hereby state that under requirements of P.A. 74, Michigan P.A. of 1970, the corner points mentioned in lines 1 and 2 above were in conformance with regulations and rules therefore as required in the current manual of survey instruction of the United States Department of the interior, Bureau of Land Management or by a decree of a Court of Law and/or that the corner points mentioned in lines 3, 4 and 5 above were in conformance with the rules of the Michigan Board of Land Surveyors or by a Decree of a Court of Law, established, re-established, monumented, recovered, found as expressed below.

	A	B	C	D	E	F	G	H	I	J	K	L	M
1													
2	6	5	4	3	2								
3													
4	7	8	9	10	11	12							
5													
6	18	17	16	15	14	13							
7													
8	19	20	21	22	23	24							
9													
10	30	29	28	27	26	25							
11													
12	31	32	33	34	35	36							
13													

NOTE: Not more than 2 corners, all in the same town and range, may be recorded on this certificate.

A. Description of original monument and accessories and/or subsequent restoration:

United States Government Survey, 1815 Instructions, Surveyed 1819, Joseph Wampler, D.S.
Bearing Trees A) Ironwood 12" N53deg.E 13.2
B) Ironwood 8" S82deg.W 11.22


Continued on Back

B. Description of corner evidence found and/or method applied in restoring or reestablishing corner:

Found 1-1/2" Iron Pipe 2.5 East of a North-South fence line

C. Description of monument for corner and accessories established to perpetuate locating the position of the corner:

Set 3/4" Iron Pipe with Remonumentation Cap in existing 1-1/2" Iron Pipe
Previous Accessory 3) NW Corner of a fence line running S'yly and E'yly, S'yly 61 feet
Previous Accessory 6) Dead Crabapple S'yly 20.0
New Accessory SW Corner of a fence line running N'yly and E'yly, S'yly 26 feet
New Accessory East end of a fence line running W'yly, S'yly 45 feet
New Accessory 10" Walnut S80deg. W 266.30 Nail and RT NW/S
New Accessory SE Corner of a house N45deg. W 355.56
New Accessory NE Corner of a house N40deg. W 391.15

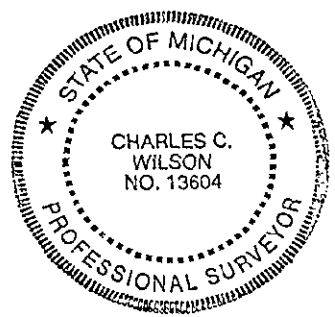

I find no evidence to conflict with the acceptance of this point as being the best available evidence for the position of this corner. This point was ratified by the Washtenaw County Peer Committee on November 15, 1999.

Signed by Charles C. Wilson
Surveyors Michigan's License No. 13604

Date November 15, 1999

APPROVED
DATE 11/15/99
CO. REP. Hx

RFI

SECTION

Paragraph A Continued

1870+- Pettibone's Witness Book on file at Atwell-Hicks Inc.

- 1) 28" Basswood S27-1/2deg.E 60.06
- 2) 40" W. Oak S72-1/2deg.E 56.76

WCRC Grid Book

- 3) E-W Fence line S'y 61.9
- 4) 14" Hickory North 198.0
- 5) 20" Oak N45deg.W 346.2

Dec. C. Wilson & Associates, Inc.

1995 Survey Drawing

Found 1-1/2" Iron Pipe 2.5 East of N-S Fence 61 North of E-W Fence

- 3) E-W Fence S'y 61
- 5) 36" Oak N45deg.W 346.8
- 6) Eastly trunk of Multi-Crabapple S'y 19.77
- 7) Easterly trunk of Mult-Crabapple N'y 153.60



5094778

Page: 2 of 2
02/07/2000 02:55P

Peggy M. Haines - Washtenaw Co. CORREM L-3 P-70