

SECTION

LAND CORNER RECORDATION CERTIFICATE
Filing Requirement of Act 74, Mich; P.A. 1970

For corner in

Washtenaw
(County)

Located in:

Corner Code #

1. Public Land Survey

T 2S R 7E

H-11

T _____ R _____

T _____ R _____

T _____ R _____

2. Property Controlling
in Section

S _____

T _____ R _____

S _____

T _____ R _____

3. Miscellaneous
Property in Sec

S _____

T _____ R _____

S _____

T _____ R _____



5094779
Page: 1 of 2
02/07/2000 02:55P
L-3 P-71

Register of Deeds Stamp & File Number

4. Lot No. _____, Recorded Plat _____
5. Private Claims _____

I, Charles C. Wilson, in a field survey on September, 19 99, do hereby state that under requirements of P.A. 74, Michigan P.A. of 1970, the corner points mentioned in lines 1 and 2 above were in conformance with regulations and rules therefore as required in the current manual of survey instruction of the United States Department of the interior, Bureau of Land Management or by a decree of a Court of Law and/or that the corner points mentioned in lines 3, 4 and 5 above were in conformance with the rules of the Michigan Board of Land Surveyors or by a Decree of a Court of Law, established, re-established, monumented, recovered, found as expressed below.

NOTE: Not more than 2 corners, all in the same town and range, may be recorded on this certificate.

	A	B	C	D	E	F	G	H	I	J	K	L	M
1													
2	8	5	4	3	2	1							
3													
4	7	8	9	10	11	12							
5													
6	18	17	16	15	14	13							
7													
8	19	20	21	22	23	24							
9													
10	30	29	28	27	26	25							
11													
12	31	32	33	34	35	36							
13													

A. Description of original monument and accessories and/or subsequent restoration:

United States Government Survey, 1815 Instructions, Surveyed 1819, Joseph Wampler, D.S.
Bearing Trees A) W. Oak 22" N20deg.E 15.18
B) W. Oak 22" S34deg.E 14.52

Continued on Back


B. Description of corner evidence found and/or method applied in restoring or reestablishing corner:

Found a railroad spike inside a 3/4" Iron Pipe inside a 1-1/4" Iron Pipe, 1.5 North of bituminous surface on Geddes Road, 0.8 below bituminous surface.

C. Description of monument for corner and accessories established to perpetuate locating the position of the corner:

Removed railroad spike and set Remonumentation Cap on existing 3/4" Iron Pipe inside existing 1-1/4" Iron Pipe, 0.6 below bituminous surface
Previous Accessory 2) 26" Oak N50deg.E 32.35 Nail and RT NW/S
Previous Accessory 3) 16" Butternut N60deg.E 45.21 Nail and RT NW/S
Previous Accessory 4) 16" Butternut N65deg.E 59.78 Nail and RT S/S
Previous Accessory 5) 18" Forked Butternut N70deg.E 67.80 Nail and RT S/S
Previous Accessory 6) 24" Maple S35deg.E 55.00 Nail and RT NE/S
Previous Accessory 8) 36" Hickory S75deg.W 107.10 Nail and RT N/S
Previous Accessory 9) 27" Butternut N10deg.W 39.54 Nail and RT E/S
New Accessory Utility Pole N70deg.W 63.43 Nail and RT S/S

I find no evidence to conflict with the acceptance of this point as being the best available evidence for the position of this corner. This point was ratified by the Washtenaw County Peer Committee on November 15, 1999. Washtenaw County Road Commission will install monument box at a later date.

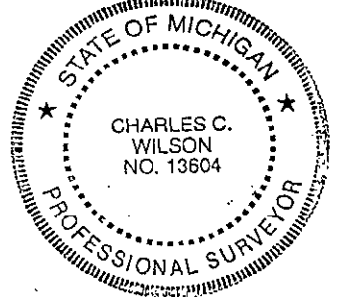

Signed by Charles C. Wilson
Surveyors Michigan's License No. 13604

Date November 15, 1999

APPROVED
DATE 11/15/99
CO. REP. K/S

REV

2000

SECTION



5094779
Page: 2 of 2
02/07/2000 02:55P

Peggy M. Haines - Washtenaw Co. CORREM L-3 P-72

Paragraph A Continued

1870+- Pettibone's Witness Book on file at Atwell-Hicks Inc.

- 1) 4" Hickory S49deg.E 26.40

Nov. WCRC Grid Book, WJ Armstrong

1934 Found hole filled with stones with wood stake in center

Set a 1-1/2" x 36" Iron Pipe, stones and bricks

- 2) 10" W. Oak N52-1/2deg.e 32.4
- 3) 6" Butternut N61deg.E 45.5
- 4) 8" Butternut N65-1/2deg.E 59.8
- 5) 10" Forked Butternut N69deg.E 67.8
- 6) 3" Maple S34deg.E 54.8
- 7) 24" Hickory S43deg.W 30.5
- 8) 22" Hickory S77deg.W 107.7
- 9) 10" Butternut N21-1/2deg.W 39.5
- 10) Iron Pipe Nly 33.0
- 11) Iron Pipe Sly 33.0

Aug. Vitins, PS #17324

1977 LCRC, Liber 4, Page 378

Found 1/2" Steel Rod

- 2) 20" Oak NE 31.95
- 12) Utility Pole NW 60.76
- 13) 20" W. Cherry SW 55.97

Mar. WCRC, Book F-10, Page 8

1994 Found 1/2" Iron Rod

- 2) 24" Oak N52-1/2deg.E 32.6
- 3) 15" Butternut N61deg.E 45.3
- 4) 15" Butternut N65-1/2deg.E 59.7
- 5) Forked Butternut N69deg.E 67.8
- 6) 22" Maple S34deg.E 55.0
- 8) 36" Hickory S77deg.W 108.1
- 9) 26" Butternut N21-1/2deg.W 39.5