

**REMONUMENTATION  
LAND CORNER RECORDATION CERTIFICATE  
Filing Requirement of Act 74, Mich. P.A. 1970**

RECORDED  
 WASHTEENAW COUNTY, MI  
 FEB 18 8 57 AM '97  
 PEGGY M. HAINES  
 COUNTY CLERK/REGISTER


For corners in <u>Washtenaw</u> (county)	Located In	Corner Code #
1. Public Land Survey	T <u>2S</u> R <u>7E</u>	<u>1-9</u>
	T _____                      R _____	_____
	T _____                      R _____	_____
	T _____                      R _____	_____
2. Property Controlling S _____ T _____	S _____ T _____                      R _____	_____
in Section	S _____ T _____                      R _____	_____
3. Miscellaneous S _____ T _____	S _____ T _____                      R _____	_____
Property in Sec.	S _____ T _____                      R _____	_____

Liber 00001 Page 05702m

Register of Deeds Stamp & File Number

4. Lot No. \_\_\_\_\_, Recorded Plat \_\_\_\_\_  
 5. Private Claims \_\_\_\_\_

I, R.T. Tietsema, in a field survey on July 31, 19 96, do hereby certify that under the requirements of P.A.74, Michigan P.A. of 1970, the corner points mentioned in lines 1 and 2 above were in conformance with the regulations and rules therefore as required in the current manual of survey instructions of the United States Department of the Interior, Bureau of Land Management of by a decree of a Court of Law and/or that the corner points mentioned in lines 3, 4, and 5 above were in conformance with the rules of the Michigan Board of Land Surveyors or by a Decree of a Court of Law; established, re-established, monumented, recovered, found as expressed below.

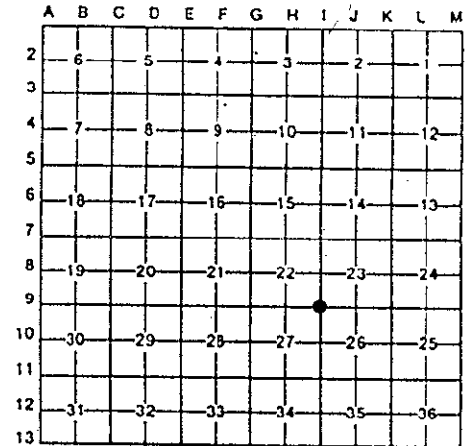

**NOTE: Not more than 4 corners, all in the same town and range, may be recorded on this certificate**

**A. Description of original monument and accessories and/or restoration:**

Set Corner of Sections 22,23,26, & 27 1819 GLO(Wrangler) Fid. Notes	Set Original Corner	1) 14" Beech N7E 2) 20" Beech S73E	32 Links(21.12') 7 Links(4.62')
9/18/1933 W.A. Beebe Resurvey (grid book)	Find Oak Stake with a 4" tile and stones around it. Reset with Iron Pipe and brick.	3) 30" B. Walnut S50W 4) 22" Spruce N65W 5) 6" Elm S12E 6) 3 Right of Way Pipes	31.3' 107.6' 117.8'

(continued on back)

**B Description of corner evidence found and/or method applied in restoring or reestablishing corner:**

Found 1 1/2" Iron Pipe 5.5' W. of Centerline of Harris Road on the Centerline of Vreeland Road 0.6' below road surface.

Also found remaining witnesses

12) SE Cor. of Hse. #2515 N. Harris Rd.	NW	134.8'
13) Street Sign Post	SW	10.25'
14) Set Nail S. side of a 8" Honeylocust	S60E	51.78'
15) Set Nail E. side of a 15" Red Maple	S70W	30.88'

**SURVEY &  
REMONUMENTATION**

MAY 05 1997

COPIES

**C Description of monument for corner and accessories established to perpetuate locating the position of the corner:**

Set 1" Pipe and Remonumentation Cap over existing pipe.  
 Set additional accessories:

9) Clothes Line Post	N70W	34.15'
12) SE Cor. of Hse. #2515 N. Harris Rd.	NW	134.8'
13) Street Sign Post	SW	10.25'
14) 8" Honeylocust	S60E	51.78' to nail & R.T.
15) 15" Red Maple	S70W	30.88' to nail & R.T.
16) 22" Oak	N05E	53.44' to nail & R.T.
17) Quad-trunk Crab Apple	S20W	69.52' to nail & R.T.
18) 8" Crab Apple	S25E	52.24' to nail & R.T.

It is our opinion that this corner represents a careful and faithful perpetuation of the position of the original corner.

Signed by R. T. Tietsema Date DEC 02 1996  
 Surveyor's Michigan License No. 20712

APPROVED  
 DATE 9/23/96  
 CO. REP. 14x

**COPY**

1986

Date	Surveyor	Block	Section	Reference	Notes	Findings	Measurements
1/22/1959	W. J. Armstrong (Atwell-Hicks)	9675	L1P345	Compiled Surveys Dwg. #242-53	Unrecorded	3) 30" B. Walnut 4) 22" Spruce 5) 6" Elm 7) 15" Locust 8) Clothes Line Post 9) Clothes Line Post 10) 12" Locust 11) 16" Elm	31.30' 107.60' 117.80' 51.30' 84.40' 36.60' 48.90' 15.00'
12/28/1971	Francis A. Papke	9675	L1P345	Boundary	End. 2" Iron Pipe	5) Nail on West side 18" Dead Elm 12) SE Corner of House #2515 N. Harris Rd. 13) Street Sign	N.N.W. (typ-o ?) 117.35' S.E. (typ-o ?) 134.80' N.N.E. (typ-o ?) 10.25'
9/28/1972	Robert A. Campbell JR. Job# 720340	13028		Boundary L1413P921	End. 1 1/2" Iron Pipe	5) Nail on West side 18" Dead Elm 9) Clothes Line Post 12) SE Corner of House #2515 N. Harris Rd. 13) Street Sign	SE 117.70' NW 34.30' NW 134.80' SW 10.25'
10/24/1977	Charles C. Wilson	13604		Boundary L1622P901	End. 1 1/2" Iron Pipe	5) Nail on West side 18" Dead Elm 9) Clothes Line Post 12) SE Corner of House #2515 N. Harris Rd. 13) Street Sign Post	SE 117.70' NW 34.30' NW 134.80' SW 10.25'
1986	W.C.R.C.			Fld. Notes	End. 1 1/2" Iron Pipe	9) Clothes Line Post 12) SE Corner of House #2515 N. Harris Rd. 13) Street Sign Post 14) Set nail S side of a 6" Honeylocust 15) Set Nail E side of a 15" Red Maple	NW 34.30' NW 134.80' SW 10.25' S60E 51.78' S70W 30.88'