

**REMONUMENTATION
LAND CORNER RECORDATION CERTIFICATE**
Filing Requirement of Act 74, Mich. P.A. 1970

RECORDING
 WASHTEENAW COUNTY, MI
 FEB 18 8 56 AM '97
 PEGGY A. HAINES
 COUNTY CLERK/REGISTRAR


For corners in <u>Washtenaw</u> (county)	Located In	Corner Code #
1. Public Land Survey	T <u>2S</u> R <u>7E</u>	<u>1-10</u>
	T _____	_____
	T _____	_____
	T _____	_____
2. Property Controlling in Section	S _____	_____
	S _____	_____
3. Miscellaneous Property in Sec.	S _____	_____
	S _____	_____

Liber 00001 Page 0568Rm

Register of Deeds Stamp & File Number

4. Lot No. _____, Recorded Plat _____
5. Private Claims _____

I, R.T. Tietsema, in a field survey on July 31, 1996, do hereby certify that under the requirements of P.A.74, Michigan P.A. of 1970, the corner points mentioned in lines 1 and 2 above were in conformance with the regulations and rules therefore as required in the current manual of survey instructions of the United States Department of the Interior, Bureau of Land Management of by a decree of a Court of Law and/or that the corner points mentioned in lines 3, 4, and 5 above were in conformance with the rules of the Michigan Board of Land Surveyors or by a Decree of a Court of Law; established, re-established, monumented, recovered, found as expressed below.

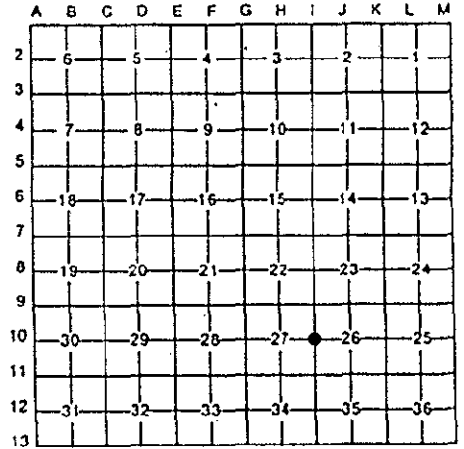

NOTE: Not more than 4 corners, all in the same town and range, may be recorded on this certificate

A. Description of original monument and accessories and/or restoration:

Set Corner of Sections 26, & 27 1819 GLO(Wrangler)	Fld. Notes	Set Original Corner	1) 4" Ironwood 2) 11" Sugar	N70E N40W	15 Links(9.9') 18 Links(11.88')
11/5/1934 W.J. Armstrong	Resurvey (grid book)	Find Petibones Wood Stake and stones. Reset with 1 1/2"x40" Iron Pipe with Bricks and Stones.	3) 8" Elm 4) 30" Elm 5) 32" Swamp Oak 6) 32" Black Oak 7) 8" Swamp Oak 8) 6" Elm 9) 10" Elm 10) 2 Right of Way Pipes	N12E N83E S24 1/2E S22E S40W S80W S88W	100.5' 32.0'and 68.5' 78.1' 42.8' 24.9' 26.0'

(continued on back)

B Description of corner evidence found and/or method applied in restoring or reestablishing corner:

Found 1 1/2" Iron Pipe Brick and Stone.
Also found remaining witnesses

4) 33" Stump	N84E	32.28'
5) 44" Oak	S24E	67.76'
7) 23" Oak	S41W	42.48'

C Description of monument for corner and accessories established to perpetuate locating the position of the corner:

Set 1" Pipe and Remonumentation Cap.
Set additional accessories:

4) 33" Stump	N65E	31.90' to nail & R.T.
5) 44" Oak	S20E	67.75' to nail & R.T.
7) 27" Oak	S40W	42.07' to nail & R.T.
14) 8" Oak	N75E	24.47' to nail & R.T.
15) 20" Elm	N27E	66.51' to nail & R.T.

It is our opinion that this corner represents a careful and faithful perpetuation of the position of the original corner.

SURVEY &
REMONUMENTATION

MAY 9 5 1997

COMMISSION

Signed by *R. T. Tietsema* Date DEC 02 1996
Surveyor's Michigan License No. 20712

FORM APPROVED BY MICHIGAN STATE BOARD OF LAND SURVEYORS, JAN. 28 1971
REVISED MAY 14, 1976
REVISED JAN., 1983

APPROVED
DATE 9/22/96
CO. REP. K

COPY

