

REMONUMENTATION

MAY 6 5 1987

COMMISSION

REMONUMENTATION LAND CORNER RECORDATION CERTIFICATE

Filing Requirement of Act 74, Mich. P.A. 1970

PEGGY H. HAINES COUNTY CLERK/REGISTER

FEB 18 9 01 AM '97

RECORDED WASHTEENAW COUNTY, MI


Table with columns: For corners in Washtenaw (county), Located In, Corner Code #. Rows include Public Land Survey, Property Controlling S in Section, and Miscellaneous Property in Sec.

Liber 00001 Page 05762m

Register of Deeds Stamp & File Number

- 4. Lot No. _____, Recorded Plat _____
5. Private Claims _____

I, R.T. Tietsema, in a field survey on August 16 19 96, do hereby certify that under the requirements of P.A. 74, Michigan P.A. of 1970, the corner points mentioned in lines 1 and 2 above were in conformance with the regulations and rules therefore as required in the current manual of survey instructions of the United States Department of the Interior, Bureau of Land Management of by a decree of a Court of Law and/or that the corner points mentioned in lines 3, 4, and 5 above were in conformance with the rules of the Michigan Board of Land Surveyors or by a Decree of a Court of Law; established, re-established, monumented, recovered, found as expressed below.

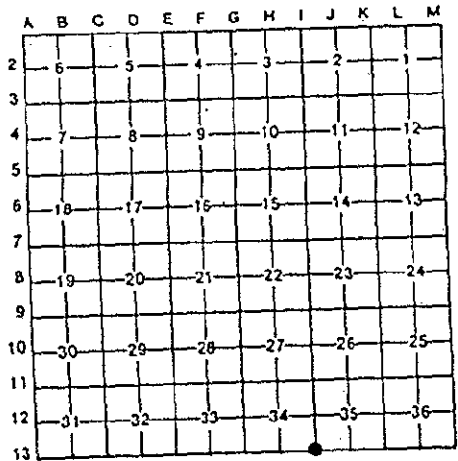

NOTE: Not more than 4 corners, all in the same town and range, may be recorded on this certificate

A. Description of original monument and accessories and/or restoration:

Table with columns: Set post corner of, Fld. Notes, Set Original Corner, and measurements. Includes entries for 14" D. Oak, 30" Elm, 24" Elm, and 8" R. Oak.

B. Description of corner evidence found and/or method applied in restoring or reestablishing corner:

In August of 1996, LSC found a 1" iron pipe 270.35' W'y (270.66 R) of the SW corner of Lot 677 of Woodland Acres Subdivision No. 8 (L21-PG34 W.C.R.) verified from the NW corner of Lot 676 (see sketch), and set four (4) witnesses. LSC found no evidence of the Closing Corner to the West (NE corner Section 3, T3S, R7E) for Ypsilanti Township to the South.

C. Description of monument for corner and accessories established to perpetuate locating the position of the corner:

Set Remon. cap over existing Pipe, and set four (4) witnesses described as :

Table with columns: Witness description, distance to nail & R.T., and notes. Includes entries for 6" multi-trunk Elm, 5" Mulberry, Field Cor. Post, and 4" mlt.-trk. Mulberry.

It is our opinion that this corner represents the original corner and is accepted as the best available evidence of the position of the corner.

Signed by [Signature] Date DEC 02 1996
Surveyor's Michigan License No. 20712

FORM APPROVED BY MICHIGAN STATE BOARD OF LAND SURVEYORS, JAN. 28 1971 REVISED MAY 14, 1975 REVISED JAN., 1983

APPROVED DATE 11/11/96 CO. REF. 12

COPY

