

SURVEY &  
REMONUMENTATION

MAY - 1 1995

COMMISSION

COPY

LAND CORNER RECORDATION CERTIFICATE  
Filing Requirement of Act 74, Mich. P.A. 1970

RECORDED  
WASHTENAW COUNTY, MI

JAN 10 9 40 AM '95

PEGGY M. HAINES  
COUNTY CLERK/REGISTER

- COPY -

For corners in  
Washtenaw  
(County)

Located In: Corner Code ##

- |                                       |                         |             |
|---------------------------------------|-------------------------|-------------|
| 1. Public Land Survey                 | T <u>2S</u> R <u>7E</u> | <u>K-10</u> |
|                                       | T _____ R _____         | _____       |
|                                       | T _____ R _____         | _____       |
|                                       | T _____ R _____         | _____       |
| 2. Property Controlling<br>in Section | S _____ T _____ R _____ | _____       |
|                                       | S _____ T _____ R _____ | _____       |
| 3. Miscellaneous<br>Property in Sec.  | S _____ T _____ R _____ | _____       |
|                                       | S _____ T _____ R _____ | _____       |
| 4. Lot No. _____, Recorded Plat _____ |                         |             |
| 5. Private Claims _____               |                         |             |

LIDER

1 PAGE 231 RM

- COPY -

Register of Deeds Stamp & File Number

I, Kenneth R. Coleman, in a field survey on December 27, 19 94, do hereby certify that under requirements of P.A. 74, Michigan P.A. of 1970, the corner points mentioned in lines 1 and 2 above were in conformance with regulations and rules therefore as required in the current manual of survey instructions of the United States Department of the Interior, Bureau of Land Management or by a decree of a Court of Law and/or that the corner points mentioned in lines 3, 4 and 5 above were in conformance with the rules of the Michigan Board of Land Surveyors or by a Decree of a Court of Law; established, re-established, monumented, re-monumented, recovered, found as expressed below:

	A	B	C	D	E	F	G	H	I	J	K	L	M
2	6		5		4		3		2		1		
3													
4	7		8		9		10		11		12		
5													
6	16		17		16		15		14		13		
7													
8	19		20		21		22		23		24		
9													
10	30		29		28		27		26		25		
11													
12	31		32		33		34		35		36		
13													

NOTE: Not more than 4 corners, all in the same town and range, may be recorded on this certificate.

A. Description of original monument and accessories and/or subsequent restoration:  
See back

B. Description of corner evidence found and/or method applied in restoring or reestablishing corner:  
Found pieces of rusted metal and pieces of brick, tile and pottery at location computed from the 1942 Warnter and Warner survey. Set a 1" x 2' I.P. w/remon. cap at the computed location. Found a 1/2" x 2 1/2' re-rod believed to have been used as K-10 in a survey by Thomas R. Kenna in 6-2-1970 8.66' EAST.


C. Description of monument for corner and accessories established to perpetuate locating the position of the corner:

- Set 1" x 2' I.P. w/remon. cap.
- 1/2" re-rod EAST 8.66
- P. pole N10°E 252.25 to nail w/W.C.R. tag
- P. pole S31°E 78.35 to nail w/W.C.R. tag
- Edge gravel WEST 3.0

I conclude that this corner is accepted as the best available evidence of the position of the original corner.

Signed by Kenneth R. Coleman Date 12-28-94

Surveyor's Michigan License No. 37271

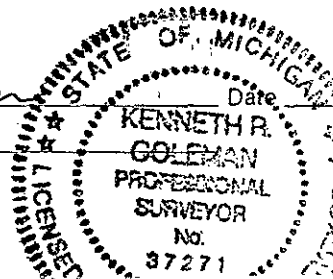

K-10, T2S, R7E

7400

LIBER

1 PAGE 232 RM  
- COPY -

A. 6-13-1939 W.J. Armstrong Wash. Co. Grid Book  
 "Found old wood stake, broken brick, tile, pottery and a horseshoe.  
 Set 1 1/2" x 40" iron pipe, stones and bricks."  
 3) 10" Elm S4½°W 468.2  
 4) 28" Elm S62½W 429.1  
 5) 14" Hickory N9¾°W 406.6  
 6) 6" Elm N2°W 288.4  
 7) T. pole N75°E 40.4  
 8) Centerline travelled grade EAST 12.4  
 Note: 7 & 8 were added at a later date

8-31-1942 Warner & Warner Survey  
 No witnesses

12-19-1950 Atwell-Hicks, Inc. Field Book 583-59  
 "Could not locate with finder - ground frozen. Set spike at  
 intersection of witnesses from center trees"  
 3) 10" Elm S4°30'W 468.2  
 4) 28" Elm S62°32'W 429.1  
 5) 14" Hickory N9°45'W 406.1  
 6) 6" Elm N2°00'W 288.4

6-17-58 Atwell-Hicks, Inc. Field Book 605-51  
 "Could not find spike set for E 1/4 corner see book 583 p. 59."  
 "Set pipe for E 1/4 post." "Same witnesses as Co. Rd. Record."  
 7) T. pole N75°E 40.9  
 8) Centerline traveled grade EAST 12.4  
 9) Road fence line EAST 42.47  
 10) South brace post SOUTH 5.0

APPROVED

DATE 12/17/94

CO. REP. KA