

SURVEY &
REMONUMENTATION

MAY - 1 1995

COMMISSION

COPY

LAND CORNER RECORDATION CERTIFICATE
Filing Requirement of Act 74, Mich. P.A. 1970

RECORDED
WASHTENAW COUNTY, MI

JAN 10 9 40 AM '95

PEGGY M. HAINES
COUNTY CLERK/REGISTER

- COPY -

For corners in

Washtenaw
(County)

Located In:

Corner Code #

- | | | | | | | |
|---------------------------------------|---|-----------|---|-----------|-------------|-------|
| 1. Public Land Survey | T | <u>2S</u> | R | <u>7E</u> | <u>K-11</u> | |
| | T | _____ | R | _____ | _____ | |
| | T | _____ | R | _____ | _____ | |
| | T | _____ | R | _____ | _____ | |
| 2. Property Controlling in Section | S | _____ | T | _____ | R | _____ |
| | S | _____ | T | _____ | R | _____ |
| 3. Miscellaneous Property in Sec. | S | _____ | T | _____ | R | _____ |
| | S | _____ | T | _____ | R | _____ |

LIBER 1 PAGE 233 RM
- COPY -
Register of Deeds Stamp & File Number

4. Lot No. _____, Recorded Plat _____
5. Private Claims _____

| | A | B | C | D | E | F | G | H | I | J | K | L | M |
|----|----|----|----|----|----|----|---|---|---|---|---|---|---|
| 2 | 6 | 5 | 4 | 3 | 2 | 1 | | | | | | | |
| 3 | | | | | | | | | | | | | |
| 4 | 7 | 8 | 9 | 10 | 11 | 12 | | | | | | | |
| 5 | | | | | | | | | | | | | |
| 6 | 18 | 17 | 16 | 15 | 14 | 13 | | | | | | | |
| 7 | | | | | | | | | | | | | |
| 8 | 19 | 20 | 21 | 22 | 23 | 24 | | | | | | | |
| 9 | | | | | | | | | | | | | |
| 10 | 30 | 29 | 28 | 27 | 26 | 25 | | | | | | | |
| 11 | | | | | | | | | | | | | |
| 12 | 31 | 32 | 33 | 34 | 35 | 36 | | | | | | | |
| 13 | | | | | | | | | | | | | |

I, Kenneth R. Coleman, in a field survey on 11-30, 1994, do hereby certify that under requirements of P.A. 74, Michigan P.A. of 1970, the corner points mentioned in lines 1 and 2 above were in conformance with regulations and rules therefore as required in the current manual of survey instructions of the United States Department of the Interior, Bureau of Land Management or by a decree of a Court of Law and/or that the corner points mentioned in lines 3, 4 and 5 above were in conformance with the rules of the Michigan Board of Land Surveyors or by a Decree of a Court of Law; established, re-established, monumented, re-monumented, recovered, found as expressed below:

NOTE: Not more than 4 corners, all in the same town and range, may be recorded on this certificate.

A. Description of original monument and accessories and/or subsequent restoration:

See back

B. Description of corner evidence found and/or method applied in restoring or reestablishing corner:

Found 3/4" I.P. in bituminous


C. Description of monument for corner and accessories established to perpetuate locating the position of the corner:

Found 3/4" iron pipe in hole in bituminous

- | | | |
|---------------------------|--------|----------------------------|
| 10) NW corner W'ly pillar | SW | 53.3 |
| 11) NE corner E'ly pillar | SE | 40.2 |
| 14) Center pavement | SOUTH | 4.5 |
| 15) Utility pole | N55° E | 47.92 to nail w/W.C.R. tag |
| 16) Power pole | N23° E | 82.38 to nail w/W.C.R. tag |
| 17) Utility pole | N75° W | 89.96 to nail w/W.C.R. tag |
| 18) Utility pole | S19° E | 32.52 to nail w/W.C.R. tag |

I conclude that this corner is a careful and faithful perpetuation of the position of the original corner.

Signed by Kenneth R. Coleman 12-28-94
Surveyor's Michigan License No. 37271

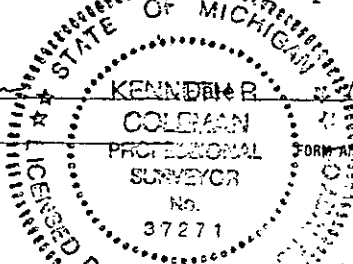

- copy -

- A. 9-1-25 Atwell-Hicks, Inc. Survey Book 502, Page 40
 Found leaning 2' iron rod surrounded by stones and broken tile with black streak below. Reset plumb with stone and tile.
- | | | |
|-----------------------|-------|-----------------|
| 3) Telephone Pole | S21°E | 27.5 to center |
| 4) Power Pole | N30°E | 45.2 to center |
| 5) 18" Poplar | N41°E | 250.3 to center |
| 6) 6" Elm | N32°E | 168.8 to center |
| 7) 10" Elm in fence | N08°W | 193.5 to center |
| 8) 10" Telephone Pole | N21°W | 76.6 to center |
| 9) 14" Power Pole | N51°W | 59.7 to center |

No date H.H. Atwell & Royce Barens Grid Book

Iron pipe

- | | | |
|-------------------------------|-------|-----------------|
| 5) 18" Poplar | N41°E | 250.3 to center |
| 6) 6" Elm | N32°E | 168.8 to center |
| 7) 10" Elm in fence | N08°W | 193.5 to center |
| 9) 14" Power Pole | N65°W | 59.7 to center |
| 10) NW cor. W'ly brick pillar | SW | 53.3 |
| 11) NE cor. E'ly brick pillar | SE | 40.37 |
| 13) 18" Elm | SW | 126.4 |
| 14) Center to black top | SOUTH | 7' |
- ("original C.L. as surveyed in 1922" is shown 7.5' south of NW corner)

11-12-76 Washtenaw Engineering Survey, L. 1576, P. 165

Found iron pipe

- | | | |
|-------------------------|------------|-------|
| 3) Power pole | S30°E | 27.0 |
| 10) NW cor. W'ly pillar | SW | 53.3 |
| 11) NE cor. E'ly pillar | SW (typo?) | 40.32 |
| 14) Center of pavement | SOUTH | 7.5 |
| 15) Power pole | N60°E | 48.15 |

1-22-91 Michael J. Milletics #29249 L.C.R.C. L.7, P. 265

Found re-rod

- | | | |
|----------------|------|------------------|
| 15) Power pole | NE | 48.04 PK NW side |
| 16) Power pole | N.NE | 82.41 PK W side |
| 17) Power pole | W.NW | 90.04 PK S side |
| 18) Light pole | S.SE | 32.56 PK NE side |

APPROVED

DATE 11/21/94

CO. REP. KA