

SURVEY &
REMONUMENTATION

MAY - 1 1995

COMMISSION

COPY

LAND CORNER RECORDATION CERTIFICATE
Filing Requirement of Act 74, Mich. P.A. 1970

RECORDED
WASHTENAW COUNTY, MI

JAN 10 9 40 AM '95

PEGGY M. HAINES
COUNTY CLERK/REGISTER

- COPY -

For corners in

Washtenaw
(County)

Located In:

Corner Code ##

- | | | | | | |
|---------------------------------------|---|----|---|----|------|
| 1. Public Land Survey | T | 2S | R | 7E | K-12 |
| | T | | R | | |
| | T | | R | | |
| | T | | R | | |
| 2. Property Controlling in Section | S | | T | R | |
| | S | | T | R | |
| 3. Miscellaneous Property in Sec. | S | | T | R | |
| | S | | T | R | |

LIBER

1 PAGE 235 RM

Register of Deeds Stamp & File Number

4. Lot No. _____, Recorded Plat _____
5. Private Claims _____

| | A | B | C | D | E | F | G | H | I | J | K | L | M |
|----|----|---|----|---|----|---|----|---|----|---|----|---|---|
| 2 | 6 | | 5 | | 4 | | 3 | | 2 | | 1 | | |
| 3 | | | | | | | | | | | | | |
| 4 | 7 | | 8 | | 9 | | 10 | | 11 | | 12 | | |
| 5 | | | | | | | | | | | | | |
| 6 | 18 | | 17 | | 16 | | 15 | | 14 | | 13 | | |
| 7 | | | | | | | | | | | | | |
| 8 | 19 | | 20 | | 21 | | 22 | | 23 | | 24 | | |
| 9 | | | | | | | | | | | | | |
| 10 | 30 | | 29 | | 28 | | 27 | | 26 | | 25 | | |
| 11 | | | | | | | | | | | | | |
| 12 | 31 | | 32 | | 33 | | 34 | | 35 | | 36 | | |
| 13 | | | | | | | | | | | | | |

I, Kenneth R. Coleman in a field survey on November 30, 19 94, do hereby certify that under requirements of P.A. 74, Michigan P.A. of 1970, the corner points mentioned in lines 1 and 2 above were in conformance with regulations and rules therefore as required in the current manual of survey instructions of the United States Department of the Interior, Bureau of Land Management or by a decree of a Court of Law and/or that the corner points mentioned in lines 3, 4 and 5 above were in conformance with the rules of the Michigan Board of Land Surveyors or by a Decree of a Court of Law; established, re-established, monumented, re-monumented, recovered, found as expressed below:

NOTE: Not more than 4 corners, all in the same town and range, may be recorded on this certificate.

A. Description of original monument and accessories and/or subsequent restoration:
See back

B. Description of corner evidence found and/or method applied in restoring or reestablishing corner:
Found 4" steel pipe filled w/concrete w/re-bar in center. Removed and replaced w/1" x 2' iron pipe w/remon. cap.


C. Description of monument for corner and accessories established to perpetuate locating the position of the corner:
Found 4" steel pipe w/concrete w/re-bar in center. Removed and replaced with 1" x 2' iron pipe w/remon. cap.
2) 42" Oak S40°E 58.90 to nail w/W.C.R. tag
3) 24" Poplar S45°W 13.68 to nail w/W.C.R. tag
4) 24" Poplar S85°E 48.32 to nail w/W.C.R. tag
5) 20" Boxelder N45°W 27.29 to nail w/W.C.R. tag

I conclude that this corner is accepted as the best available evidence of the position of the original corner.

igned by Kenneth R. Coleman

Date 12-28-94

urveyor's Michigan License No. 37271

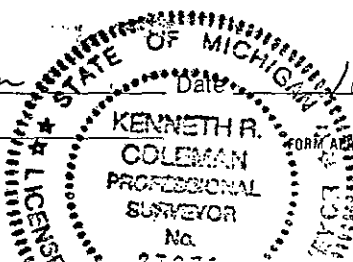

FORM APPROVED BY MICHIGAN STATE BOARD OF LAND SURVEYORS, JAN. 28, 1971
REVISED MAY 14, 1975
REVISED JAN., 1983

K-12, T2S, R7E

11-12-76

LIBER

1 PAGE 236 RM

- copy -

A. 8-27-1925 Atwell-Hicks Book 502, Page 34, F. Stoll
"Did not dig for E 1/4 post Sec. 35. It is probably a hopeless
business to expect to find anything more than the fence corner."

12-2-1956 Atwell-Hicks, Inc. Survey drw. 241-80
W 1/4 Sec. 36 is shown as a monument on survey drawing.

11-12-76 Washtenaw Eng. Survey, L. 1576, P. 165

Found monument

| | | |
|-----------------|-------|------|
| 1) 14" Boxelder | EAST | 17.1 |
| 2) 36" Oak | S55°E | 61.3 |
| 3) 18" Poplar | S50°W | 14.3 |

APPROVED

DATE 12/6/94

CO. REP. H