

SURVEY & REMONUMENTATION

MAY - 1 1995

COMMISSION

COPY

LAND CORNER RECORDATION CERTIFICATE
Filing Requirement of Act 74, Mich. P.A. 1970

RECORDED
WASHTENAW COUNTY, MI

JAN 10 9 41 AM '95

PEGGY M. HAINES
COUNTY CLERK/REGISTER

-COPY-

For corners in

Washtenaw
(County)

Located In:

Corner Code ##

- | | | | | | | |
|------------------------------------|---|-----------|---|-----------|------------|-------|
| 1. Public Land Survey | T | <u>2S</u> | R | <u>7E</u> | <u>M-9</u> | |
| | T | _____ | R | _____ | _____ | |
| | T | _____ | R | _____ | _____ | |
| | T | _____ | R | _____ | _____ | |
| 2. Property Controlling in Section | S | _____ | T | _____ | R | _____ |
| | S | _____ | T | _____ | R | _____ |
| 3. Miscellaneous Property in Sec. | S | _____ | T | _____ | R | _____ |
| | S | _____ | T | _____ | R | _____ |

LIBER

1 PAGE 243 RM

-COPY-

Register of Deeds Stamp & File Number

4. Lot No. _____, Recorded Plat _____
5. Private Claims _____

| | A | B | C | D | E | F | G | H | I | J | K | L | M |
|----|----|----|----|----|----|----|---|---|---|---|---|---|---|
| 2 | 6 | 5 | 4 | 3 | 2 | 1 | | | | | | | |
| 3 | | | | | | | | | | | | | |
| 4 | 7 | 8 | 9 | 10 | 11 | 12 | | | | | | | |
| 5 | | | | | | | | | | | | | |
| 6 | 18 | 17 | 16 | 15 | 14 | 13 | | | | | | | |
| 7 | | | | | | | | | | | | | |
| 8 | 19 | 20 | 21 | 22 | 23 | 24 | | | | | | | |
| 9 | | | | | | | | | | | | | |
| 10 | 30 | 29 | 28 | 27 | 26 | 25 | | | | | | | |
| 11 | | | | | | | | | | | | | |
| 12 | 31 | 32 | 33 | 34 | 35 | 36 | | | | | | | |
| 13 | | | | | | | | | | | | | |

I, Kenneth R. Coleman, in a field survey on December 21, 19 94, do hereby certify that under requirements of P.A. 74, Michigan P.A. of 1970, the corner points mentioned in lines 1 and 2 above were in conformance with regulations and rules therefore as required in the current manual of survey instructions of the United States Department of the Interior, Bureau of Land Management or by a decree of a Court of Law and/or that the corner points mentioned in lines 3, 4 and 5 above were in conformance with the rules of the Michigan Board of Land Surveyors or by a Decree of a Court of Law; established, re-established, monumented, re-monumented, recovered, found as expressed below:

NOTE: Not more than 4 corners, all in the same town and range, may be recorded on this certificate.

A. Description of original monument and accessories and/or subsequent restoration:
See back

B. Description of corner evidence found and/or method applied in restoring or reestablishing corner:
Searched for corner in cultivated field at location computed from prior surveys. Found a 1" O.D. x 10" piece of broken, rusty, split seam pipe lying horizontally near surface. Set a 1" x 24" iron pipe with remonumentation cap 1.1 feet below surface at computed location. Found a 1/2" bar 6" below surface 15.4 feet East. Dug down rod 18". Rod was bent at that depth and was deeper.

C. Description of monument for corner and accessories established to perpetuate locating the position of the corner:
Set 1" x 2' I.P. w/remon. cap.


See back for witnesses

8

Note: This corner has been used as A-9, T2S, ~~R7E~~, Canton Township, Wayne County.

I conclude that this corner is accepted as the best available evidence of the position of the original corner.

Signed by Kenneth R. Coleman

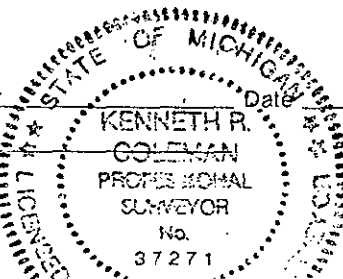

Date 12-28-94

Surveyor's Michigan License No. 37271

- COPY -

M-9, T2S, R7E

| | | | |
|---------------|--------------|-------|------------------|
| A. No date | S. Pettibone | | Compiled drawing |
| 3) 8" W. Ash | | S54°W | 95 lks. |
| 4) 6" Elm | | N22°E | 1.22 ch. |
| 5) 12" Lyndon | | S42°E | 62 lks |

1942 Atwell-Hicks, Inc. Survey by others
 Corner used in survey

| | | | |
|----------------------------------|--|-------|--------------------------|
| C. Set 1" x 2' I.P. w/remon. cap | | | |
| 6) NE corner barn | | S23°E | 190.14 |
| 7) NW corner barn | | S74°W | 210.36 |
| 8) P. pole | | N77°W | 243.66 nail & remon. tag |
| 9) P. pole | | N36°W | 280.09 nail & remon. tag |
| 10) 1/2" rod | | N89°E | 15.35 |
| 11) PK in C.L. Ridge Road | | N 2°W | 612.88 |

APPROVED

DATE 12/22/94

CO. REP. KA