

SURVEY & REMONUMENTATION

MAY - 1 1995

COMMISSION

COPY

LAND CORNER RECORDATION CERTIFICATE
Filing Requirement of Act 74, Mich. P.A. 1970

RECORDED
WASHTENAW COUNTY, MI

JAN 10 9 41 AM '95

PEGGY H. HAINES
COUNTY CLERK/REGISTER

-COPY-

For corners in

<u>Washtenaw</u> (County)	Located In:	Corner Code #
1. Public Land Survey	T <u>2S</u> R <u>7E</u>	<u>M-11</u>
	T _____ R _____	_____
	T _____ R _____	_____
	T _____ R _____	_____
2. Property Controlling in Section	S _____ T _____ R _____	_____
	S _____ T _____ R _____	_____
3. Miscellaneous Property in Sec.	S _____ T _____ R _____	_____
	S _____ T _____ R _____	_____

LIBER 1 PAGE 245 RM

-COPY-

Register of Deeds Stamp & File Number

4. Lot No. _____, Recorded Plat _____
5. Private Claims _____

I, Kenneth R. Coleman, in a field survey on November 30, 19 94, do hereby certify that under requirements of P.A. 74, Michigan P.A. of 1970, the corner points mentioned in lines 1 and 2 above were in conformance with regulations and rules therefore as required in the current manual of survey instructions of the United States Department of the Interior, Bureau of Land Management or by a decree of a Court of Law and/or that the corner points mentioned in lines 3, 4 and 5 above were in conformance with the rules of the Michigan Board of Land Surveyors or by a Decree of a Court of Law; established, re-established, monumented, re-monumented, recovered, found as expressed below:

NOTE: Not more than 4 corners, all in the same town and range, may be recorded on this certificate.

A. Description of original monument and accessories and/or subsequent restoration:
See back

	A	B	C	D	E	F	G	H	I	J	K	L	M
2	6		5		4		3		2		1		
3													
4	7		8		9		10		11		12		
5													
6	16		17		16		15		14		13		
7													
8	19		20		21		22		23		24		
9													
10	30		29		28		27		26		25		
11													
12	31		32		33		34		35		36		
13													

B. Description of corner evidence found and/or method applied in restoring or reestablishing corner:
Found 3/4" capped I.P. in mon. box. Mon. box is 0.3' below bituminous surface.


C. Description of monument for corner and accessories established to perpetuate locating the position of the corner:
Found 3/4" capped I.P. in mon. box. Mon. box is 0.3' below bituminous surface.
See back for witnesses

NOTE: This corner has been used as A-11, T2S, R8E, Canton Township, Wayne County.

I conclude that this corner is accepted as the best available evidence of the position of the original corner.

Signed by Kenneth R. Coleman Date 12-28-94

Surveyor's Michigan License No. 37271

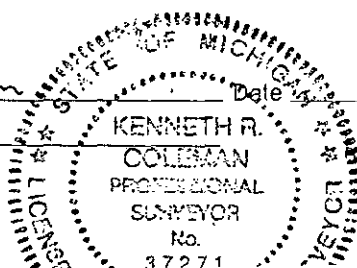

- Copy -

- A. 8-4-1932 Armstrong & R. Barns Grid Book
 Found an old wood stake, stones bricks and broken crockery. Reset with a 1 1/2" x 42" iron pipe with stones and brick around it.
- | | | |
|------------------|-------|------|
| 3) 12" Walnut | S70°? | 80.6 |
| 4) 10" Walnut | S62°? | 61.3 |
| 5) 14" Elm | S56°? | 49.8 |
| 6) 36" Elm clump | S02°E | 78.2 |
- 5-19-72 Howard Taft #12032 L.C.R.C. L.3, P. 335
 Found re-rod in mon. box
- | | | |
|-----------------------|-------|-------|
| 7) R.O.W. pipe | NORTH | 33.0 |
| 8) R.O.W. pipe | SOUTH | 33.0 |
| 9) 4" steel road sign | NORTH | 28.9 |
| 10) Utility pole | S05°E | 29.3 |
| 11) Utility pole | S75°E | 104.9 |
- 12-12-1977 Robert E. Burris, Sr. Survey, L. 1630, P. 592
 Found re-rod in mon. box
- | | | |
|-----------------------|-------|-------|
| 7) R.O.W. pipe | NORTH | 33.0 |
| 8) R.O.W. pipe | SOUTH | 33.0 |
| 9) 4" steel road sign | NORTH | 28.9 |
| 10) Utility pole | S05°E | 29.3 |
| 11) Utility pole | S75°E | 104.9 |
- C. 11-30-94 Atwell-Hicks, Inc. Remonumentation
 Found 3/4" capped I.P. in mon. box. Mon. box is 0.3 below bituminous
- | | | |
|-----------------------|-------|-----------------------------|
| 7) 1 1/2" R.O.W. pipe | NORTH | 33.01 |
| 8) 1 1/2" R.O.W. pipe | SOUTH | 33.20 |
| 9) 4" steel post | NORTH | 29.9 |
| 10) Utility pole | S06°E | 29.72 to nail w/W.C.R. tag |
| 11) Utility pole | S72°E | 105.08 to nail w/W.C.R. tag |
| 12) Guy pole | N01°E | 31.79 to nail w/W.C.R. tag |
| 13) Power pole | N72°E | 106.31 to nail w/W.C.R. tag |
| 14) C.L. bituminous | NORTH | 1.3 |

APPROVED

DATE 12/12/94

CO. REP. A