

SURVEY &
REMONUMENTATION

MAY - 1 1995

COMMISSION

COPY

LAND CORNER RECORDATION CERTIFICATE
Filing Requirement of Act 74, Mich. P.A. 1970

RECORDED
WASHTENAW COUNTY, MI

JAN 10 9 42 AM '95

PEGGY M. HAINES
COUNTY CLERK/REGISTER

- COPY -

For corners in

Washtenaw

(County)

Located in:

Corner Code #

1. Public Land Survey	T	2S	R	7E	M-13
	T		R		
	T		R		
	T		R		
2. Property Controlling in Section	S		T	R	
	S		T	R	
3. Miscellaneous Property in Sec.	S		T	R	
	S		T	R	

LIBER

1 PAGE 249 RM

- COPY -

Register of Deeds Stamp & File Number

4. Lot No. _____, Recorded Plat _____
5. Private Claims _____

	A	B	C	D	E	F	G	H	I	J	K	L	M
2	6		5		4		3		2		1		
3													
4	7		8		9		10		11		12		
5													
6	18		17		16		15		14		13		
7													
8	19		20		21		22		23		24		
9													
10	30		29		28		27		26		25		
11													
12	31		32		33		34		35		36		
13													

I, Kenneth R. Coleman, in a field survey on December 21, 19 94, do hereby certify that under requirements of P.A. 74, Michigan P.A. of 1970, the corner points mentioned in lines 1 and 2 above were in conformance with regulations and rules therefore as required in the current manual of survey instructions of the United States Department of the Interior, Bureau of Land Management or by a decree of a Court of Law and/or that the corner points mentioned in lines 3, 4 and 5 above were in conformance with the rules of the Michigan Board of Land Surveyors or by a Decree of a Court of Law; established, re-established, monumented, re-monumented, recovered, found as expressed below:

NOTE: Not more than 4 corners, all in the same town and range, may be recorded on this certificate.

A. Description of original monument and accessories and/or subsequent restoration:
See back

B. Description of corner evidence found and/or method applied in restoring or reestablishing corner:
Found PK nail in bituminous. Found 5/8" x 1' bent I.P. w/brick pieces under PK nail.
Found leaning 2" x 2" wooden stake under 5/8" I.P. Set 1" x 2' I.P. w/remon. cap.


C. Description of monument for corner and accessories established to perpetuate locating the position of the corner:
Set 1" x 2" I.P. w/remon. cap.

See back for witnesses

I conclude that this corner is accepted as the best available evidence of the original corner.

signed by Kenneth R Coleman

Surveyor's Michigan License No. 37271

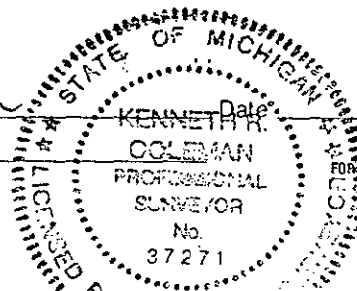

Date 12-28-94

M-13, T2S, R7E

LIBER

1 PAGE 250 RM

- COPY -

A. 1-3-1934 Armstrong Grid Book
Found a ford piston set on end with stones around it. Reset with
1 1/2" x 42" iron pipe, replaced stones and old piston and put 4
bricks around it.

3) 12" Elm	S31°E	38.6
4) 3" Twin Elm	N63½°W	48.6
5) 4" Elm	N68°E	63.7
6) 6" Ash	N71°E	69.3
7) 2 R.O.W. pipes		

(Note: All were crossed out except #6 (24" stump) and #7.)

12-13-51 Atwell-Hicks, Inc. Book 583, Page 67
"Established SE cor. Sec. 36 from witnesses. This point is in the
center of Mott Road."

3-18-1980 Washtenaw Eng. L.C.R.C. L. 6, P. 15
Found 1 1/2" iron pipe

6) 22" Ash	N71°E	68.65 to nail
8) Power pole	NORTH	50.80 to nail
9) Power pole	S60°E	119.23 to nail
10) Power pole	S40°W	31.43 to nail

5-1-1990 MCI Survey

Found PK nail		
8) Utility pole	NORTH	50.81
9) Utility pole	S60°E	118.88
10) Utility pole	S40°W	31.39
11) 18" Willow	S15°E	82.88

C. Set 1" x 2' I.P. w/remon. cap

8) Utility pole	NORTH	50.79 to nail w/W.C.R. tag
9) Power pole	S60°E	118.65 to nail w/W.C.R. tag
10) Power pole	S40°W	31.33 to nail w/W.C.R. tag
11) Twin 30" Willow	S20°E	82.85 to nail w/W.C.R. tag
12) C.L. bituminous	SOUTH	1.0

APPROVED

DATE 11/21/94

CO. REP.