

SURVEY & REMONUMENTATION

LAND CORNER RECORDATION CERTIFICATE
Filing Requirement of Act 74, Mich. P.A. 1970

NOV 02 1999

For corners in

<u>WASHTENAW</u> (County)	Located In:	Corner Code #
	SHARON TOWNSHIP	
1. Public Land Survey	T <u>3S</u> R <u>3E</u>	<u>K-7</u>
	T _____ R _____	_____
	T _____ R _____	_____
	T _____ R _____	_____
2. Property Controlling in Section	S _____ T _____ R _____	_____
	S _____ T _____ R _____	_____
3. Miscellaneous Property in Sec.	S _____ T _____ R _____	_____
	S _____ T _____ R _____	_____

SECTION

5017312
Page: 1 of 2
02/25/1999 02:59P
Peggy M. Haines - Washtenaw Co. CORREM L-2 P-190
Register of Deeds Stamp & File Number

4. Lot No. _____, Recorded Plat _____
5. Private Claims _____

I, PAUL V. SCHWIMMER, in a field survey on OCT 28, 19 98 do hereby state that under requirements of P.A. 74, Michigan P.A. of 1970, the corner points mentioned in lines 1 and 2 above were in conformance with regulations and rules therefore as required in the current manual of survey instructions of the United States Department of the Interior, Bureau of Land Management or by a decree of a Court of Law and/or that the corner points mentioned in lines 3, 4 and 5 above were in conformance with the rules of the Michigan Board of Land Surveyors or by a Decree of a Court of Law; established, re-established, monumented, recovered, found as expressed below:

1	A	B	C	D	E	F	G	H	I	J	K	L	M
2	6		5		4		3		2		1		
3													
4	7		8		9		10		11		12		
5													
6	18		17		16		15		14		13		
7													
8	19		20		21		22		23		24		
9													
10	30		29		28		27		26		25		
11													
12	31		32		33		34		35		36		
13													

NOTE: Not more than 2 corners, all in the same town and range, may be recorded on this certificate.

A. Description of original monument and accessories and/or subsequent restoration:

- G.L.O. WITNESSES FROM NOTES (1816) SET CORNER
- W. OAK 15' N 62°E 82 LINKS (1) (GONE)
- W. OAK 8' S 45°W 1.20 CHAINS (2) (GONE)
- W. OAK 6' S 82°W .56 CHAINS (3) (GONE)
- CHERRY 6' N 63°E .605 (4) (GONE)

(CONTINUED ON BACK)


B. Description of corner evidence found and/or method applied in restoring or reestablishing corner:

FOUND 1 1/2" IRON IN MONUMENT BOX FROM PREVIOUS WITNESSES. I DROVE AN ALUMINUM REMONUMENTATION CAP ONTO THE IRON.

THE SELECTED LOCATION IS ACCEPTED BY THE CONTRACTOR AND IS GENERALLY ACCEPTED BY PROFESSIONAL SURVEYORS AS THE BEST AVAILABLE EVIDENCE OF THE POSITION OF THE ORIGINAL CORNER.

C. Description of monument for corner and accessories established to perpetuate locating the position of the corner:

- K-7 N.W. CORNER OF SECTION 24 SHARON TOWNSHIP
- FOUND 1 1/2" IRON IN MONUMENT BOX. SET ALUMINUM REMONUMENTATION CAP ON IRON. IRON IS IN CENTERLINE OF ASPHALT M-52
- N 40°E 39.6' (MEAS 39.08) 18' MAPLE WITH NAIL & REMON. TAG IN S-SIDE (6)
- N 30°W 80.7 (80.52 MEAS) TELE. POLE WITH NAIL AND REMON. TAG IN S.W. SIDE (9)
- S 20°W 148.30 POWER POLE WITH NAIL & TAG IN E-SIDE
- N 30°E 59.0' (MEAS 58.64') 12' MAPLE WITH NAIL & TAG IN S-SIDE (11)

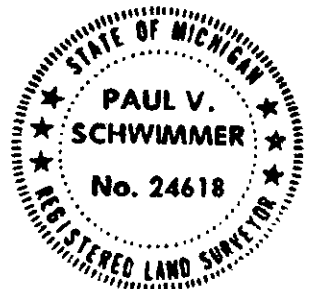

Signed by Paul V. Schwimmer

Date 12-07-1998

COPY

APPROVED
DATE 12-14-98
CO. REP. FA

A:

10\31\1972 ACT 74 RECORDED IN LIBER 2, PAGE 457

FOUND 1 1/2" IRON PIPE (5)
N 40°E 39.6 18" MAPLE (6)
N 85°E 69.8 2" WILLOW (7)
S 70°W 96.6 4" MAPLE (8)
N 30°W 80.7 TELEPHONE POLE (9)
CORNER IS IN CENTERLINE OF ASPHALT

11-1-1972 WASHTENAW ENGINEERING SURVEY JOB NO. 9390, RECORDED IN LIBER 1430, PAGE 975

FOUND 1 1/2" IRON PIPE (5)
N 40°E 39.6 18" MAPLE (6)
N 85°E 69.8 2" WILLOW (7)
S 70°W 96.6 4" MAPLE (8)
N 30°W 80.7 TELEPHONE POLE (9)
CORNER IS IN CENTERLINE OF ASPHALT

EVIDENCE FROM AN ACT 74 FILED IN 1978 BY THE MICHIGAN DEPARTMENT OF HIGHWAY FOR K-8 INDICATES THAT THE IRON (K-7) WAS SET IN A MONUMENT BOX DURING ROAD RECONSTRUCTION. THE K-8 L.C.R.C. WAS RECORDED IN LIBER 5, PAGE 135.

10-27-1998 ATWELL HICKS SURVEY DRAWING NO. 547-88, RECORDED IN L.1783, P.783, SHOWS WITNESSES:

FOUND 3/4" IRON IN MONUMENT BOX (10)
N 40°E 39.2' 18" MAPLE (6)
N 30°E 59.0' 14" MAPLE (11)
N 15°E 107.1' 20" MAPLE (12)
N 70°W 35.4' 6" SPRUCE (13)

3-25-1991 SURVEY BY C. WILSON & ASSOC. JOB NO. 91010

IRON PIPE IN MON. BOX (5)
N 40°E 39.6' 18" MAPLE (6)
S 70°W 96.6' 4" MAPLE (14)
N 30°W 80.7' TELEPHONE POLE (9)
S 75°W 85.5' 9" CHERRY (15)
S 60°W 96.4' 22" HICKORY (16)



5017312

Page: 2 of 2

02/25/1999 02:59P

Peggy M. Haines - Washtenaw Co. CORREM L-2 P-191

COPY

SURVEY &
REMONUMENTATION

NOV 02 1999

SECTION