

LAND CORNER RECORDATION CERTIFICATE
Filing Requirement of Act 74, Mich. P.A. 1970

SURVEY &
REMONUMENTATION

For corners in

NOV 02 1999

WASHTENAW
(County)

Located In: SHARON TOWNSHIP Corner Code # _____

1. Public Land Survey T 3S R 3E 1-5
T _____ R _____
T _____ R _____
T _____ R _____

2. Property Controlling S _____ T _____ R _____
in Section S _____ T _____ R _____

3. Miscellaneous S _____ T _____ R _____
Property in Sec. S _____ T _____ R _____

SECTION



5017314
Page: 1 of 2
02/25/1999 02:59P
Peggy M. Haines - Washtenaw Co. CORREM L-2 P-194

Register of Deeds Stamp & File Number

4. Lot No. _____, Recorded Plat _____
5. Private Claims _____

	A	B	C	D	E	F	G	H	I	J	K	L	M
1													
2	6		5		4		3		2		1		
3													
4	7		8		9		10		11		12		
5													
6	18		17		16		15		14		13		
7													
8	19		20		21		22		23		24		
9													
10	30		29		28		27		26		25		
11													
12	31		32		33		34		35		36		
13													

I, PAUL V. SCHWIMMER, in a field survey on OCT 28, 19 98 do hereby state that under requirements of P.A. 74, Michigan P.A. of 1970, the corner points mentioned in lines 1 and 2 above were in conformance with regulations and rules therefore as required in the current manual of survey instructions of the United States Department of the Interior, Bureau of Land Management or by a decree of a Court of Law and/or that the corner points mentioned in lines 3, 4 and 5 above were in conformance with the rules of the Michigan Board of Land Surveyors or by a Decree of a Court of Law; established, re-established, monumented, recovered, found as expressed below:

NOTE: Not more than 2 corners, all in the same town and range, may be recorded on this certificate.

A. Description of original monument and accessories and/or subsequent restoration:

G.L.D. WITNESSES FROM NOTES (1816) SET 1/4 POST
W. OAK 14' S 53°E 85 LINKS (1)
Y. OAK 20' S09°E 57 LINKS (2)
WASHTENAW COUNTY REMONUMENTATION (1934)
W.J. ARMSTRONG FOUND AN OLD WOOD STAKE AND REPLACED IT WITH A 1 1/4" IRON PIPE WITH A MASS OF STONES AROUND IT. HE ALSO PLACED 4 BRICKS AROUND THE TOP OF THE PIPE.
N 28°E 86.7' B. WALNUT (3) (GONE)
S 73°W 84.4' B. WALNUT (4) (GONE)
S 57°W 32.35' W. CHERRY (5) (GONE)
S 52°W 30.15' W. CHERRY (6) (GONE)
(CONTINUED ON BACK)


B. Description of corner evidence found and/or method applied in restoring or reestablishing corner:

ON OCTOBER 29, 1998, ALL OF THE ABOVE WITNESSES WERE GONE. I CONDUCTED A SEARCH OF THE FLOOR OF THE GRAVEL PIT AND FOUND SURVEYOR WILSON'S 2" IRON PIPE IN GOOD CONDITION. I DROVE A 1" IRON PIPE INTO THE EXISTING IRON AND SET AN ALUMINIUM REMONUMENTATION CAP ON IT.

THE SELECTED LOCATION IS ACCEPTED BY THE CONTRACTOR AND IS GENERALLY ACCEPTED BY PROFESSIONAL SURVEYORS AS THE BEST AVAILABLE EVIDENCE OF THE POSITION OF THE ORIGINAL CORNER.

C. Description of monument for corner and accessories established to perpetuate locating the position of the corner:

L-5 N 1/4 CORNER OF SECTION 13 SHARON TOWNSHIP
FOUND 2" IRON PIPE ON FLOOR OF GRAVEL PIT. SET 1" IRON WITH ALUMINIUM REMONUMENTATION CAP INTO THE EXISTING IRON.
N 71°W 285.50' 36" LOCUST WITH NAIL & REMON TAG IN S-SIDE.
N 69°W 282.91'
N 12°E 149.46' 12" TWIN LOCUST WITH NAIL & REMON TAG IN W-SIDE.
N 32°E 200.71' 18" POPLAR WITH NAIL & REMON TAG IN N.W. SIDE.
N 48°E 178.08' 12" LOCUST WITH NAIL & REMON TAG IN S.E. SIDE.
S 68°E 131.98' 14" POPLAR WITH NAIL & REMON TAG IN N-SIDE.
EAST 157' EAST TOE OF SLOPE OF GRAVEL PIT.
SOUTH 102' SOUTH TOE OF SLOPE OF GRAVEL PIT.

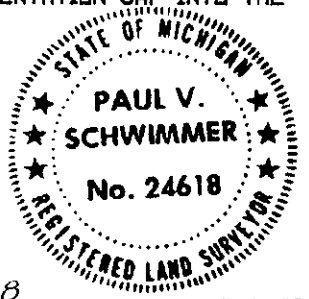

Signed by Paul V. Schwimmer

Date 12-07-1998

COPY

APPROVED
DATE 12-14-98
CO. REP. HA

A)

ARMSTRONG'S POINT WAS TIED INTO A TRAVERSE FOR A RELOCATION SURVEY OF PECKINS ROAD. WHEN THIS POINT WAS DESTROYED BY THE CREATION OF A GRAVEL PIT, SURVEYOR CHARLES C. WILSON RE-ESTABLISHED IT FROM THE ABOVE TRAVERSE AND SET A 2" IRON PIPE WITH THE FOLLOWING WITNESSES AS RECORDED IN LIBER 6, PAGE 291 OF ACT 74'S:

N 10°E 221.20' 22" OAK WITH NAIL (7) (GONE)
N 66°W 131.2' 3" LOCUST (8) (GONE)
N 09°W 111.8' 3" LOCUST (9) (GONE)
S 71°E 135.3' 3" POPULAR (10) (GONE)



5017314

Page: 2 of 2

02/26/1999 02:59P

Peggy M. Haines - Washtenaw Co. CORREM L-2 P-195

COPY

SURVEY &
REMONUMENTATION

NOV 02 1999

SECTION